

February 2, 2024

ADDENDUM NO. 1

PROJECT: New Offices for Morrow County Health District
480 Douglas St.
Mt. Gilead, OH 43338

For Morrow County Commissioners
80 N. Walnut St.
Mt. Gilead, OH 43338

BID DATE: **February 14, 2024**
TIME: **9:30 AM**

80 N. Walnut St., Mt. Gilead, OH 43338

This addendum supplements, modifies, and amends the original Contract Documents and shall become a part of said Contract. Additional work required by this Addendum shall be executed in conformance with the requirements of corresponding section of the Specifications as it applies or is amended.

ITEM #1: **RFI's** are incorporated in this addendum and contribute to the identification of RFI'd items to be include in or excluded from the contract.

ITEM #2: **Allowances:** Provide an allowance of \$7,500.00 for electronic door control hardware and an \$18,000 allowance for Versalok CMU material and installation. These allowances are to appear as a line item in the schedule of values. Costs shall be tracked on a direct-cost-plus O&P basis with evidence of costs provided against this line item.

ITEM #3: **Cutoff time for RFI's:** Final submission of RFI's is 2/2/24 4:00 PM.

ITEM #4: **Specification Section 084113:** Replace existing section with new section; changes designated in **bold**.

ITEM #5: **Specification Section 088000 – GLAZING:** Add this specification to the document set.

ITEM #6: Folding panels – Moderco Signature 842 paired panels with retractable seals are approved for use on the project.

ITEM #7: **See revised drawing sheets** T1.01, D1.01, A0.01, A1.01, A3.01, A5.01.

END OF ADDENDUM 1

Morrow County Health District Contact List

Project: 2023-029

Name	Company	Role	Phone	Email
PAUL OMNESS	ODI	AREIT	7403678947	odi
Paul Hinze	M6 Energy	HVAC/Plumb	419-522-2700	phinzp@mg.energy
Don Wiley	M6 Energy	HVAC/Plumb	419-522-2700	phinzp@mg.energy
Ben Stevens	SCC	GC	740-387-1938	ben@stevensconstruction.net
Lauren Schmenk	ACI Const. Co. Inc.	PM/Est.	419-595-4012	l.schmenk@alvada-construction.com
Bill Ryan	Division 8 Glass	OWNER/LEAD	740-802-4001	chaplazer1@gmail.com
Dan Henry	Adena Corporation	PM/Est	419-566-6194	d.henry@adena.corporation.com
Nick Bosh	Intertek PSI	PM	330-488-7361	nicholas.bosh@intertek.com

Andrew Burik	Rhythm	Project Manager	614-964-1641	aburik@Rhythm
Jede Wilson	Rhythm	ass. designer	614-378-8959	Jwilson@rhythm
BRADLEY BLUMENSTEIN	Rhythm	ARCHITECT	614-964-1641	bradleyb@rhythm-arch.com



OMNESS DESIGN, INC.
ARCHITECTURE~PLANNING
140 Fairfax Rd. ~ Marion, OH 43302
www.omnessdesign.com

MCHD RFI's

1. Can you Provide hardware specs for the aluminum door?
 - a. **Aluminum Entrance Hardware Schedule Attached**
 - b. **Revised Aluminum Entrance Spec Attached**
2. Can you provide a glass spec for aluminum doors?
 - a. **Glass Spec added.**
3. What is the extent of siding patch and repair?
 - a. **Notes on exterior elevations are being added showing s.f. of patch areas. This is an approximation and may end up being a CO in the field during construction for a credit or debit. Bid should reflect s.f. shown on elevations.**
4. We are assuming that utility charges are paid by the owner, if any?
 - a. **Owner will pay utility costs.**
5. We are assuming there is no landscaping as part of this project?
 - a. **Shrubs are not part of the contract; grading, seeding and mulching lawn where disturbed by new sidewalks is part of the contract.**
6. I want to verify that there are no allowances to be included in this project
 - a. **Include a \$5,000 allowance for electric door controls has been added to the project.**
 - b. **Include an \$18,000 allowance for the VersaLok retaining wall.**
7. Are there specs for the housekeeping pads for the condensing units and the generator
 - a. **Condenser pads basis of design – CladLife Concrete Equipment Pads 3” Thickness.**
8. What is the scope for the old existing asphalt parking lot?
 - a. **Owner will handle old and new parking lots separately. The General Contractor will be responsible for the concrete sidewalk and the patio surface.**
9. Where on the parking lot do you mill the asphalt? What depth in those areas?
 - a. **Owner will handle old and new parking lots separately. The General Contractor will be responsible for the concrete sidewalk and the patio surface.**
10. Who is to excavate the existing asphalt patch-in areas?
 - a. **Owner will handle old and new parking lots separately. The General Contractor will be responsible for the concrete sidewalk and the patio surface.**
11. EDGE requirements are mentioned several times, but no percent is listed. Please clarify if Edge participation is to be included and what percent.
 - a. **There is no EDGE requirement for the project.**
12. What is the schedule for the project?
 - a. **The project duration is set for 190 days. If acceptable bids are received on the 14th, if the selected bidder can be in contract by March 1, then it would be reasonable to anticipate construction starting by April and concluding by the end of September.**
13. There is a note that state “new or relocated fire extinguishers”. Please clarify how many extinguishers are going to be reused and how many are new.
 - a. **4 new 10 pound ABC bracket mounted extinguishers shall be furnished. The location and mounting of them shall be coordinated with the local fire official.**

14. The legends and notes referenced on sheet A 0.01 do not correlate with the drawings on page A 1.01 (example: note 4 is pointing to a pole and note 4 is about glazing). Please provide corrected legends along with a guide for the pages they correlate to.
 - a. **See revised/corrected notes referenced on the RFI.**
15. Is there flooring that needs to be demo'd? Any ceilings that need to be demo'd?
 - a. **All suspended ceilings in space to be removed. Laminate and carpet flooring in the existing office area and the existing restroom are to be removed and concrete to be cleaned of any remaining adhesive.**
16. Who pays for the special inspections noted on the drawings?
 - a. **The Owner will pay for special inspections.**
17. There is no information on landscaping. Please provide detailed information on the landscaping that is to be installed.
 - a. **Landscaping will be by Owner. The General Contractor will be responsible to grade, seed and mulch areas disturbed for the installation of sidewalks.**
18. Can we keep dirt on the site or must we haul it off?
 - a. **Haul dirt off site. Maximum stockpile duration – 72 hours.**
19. Are all rooms to have signage? There is no indication for rooms other than restrooms. Please supply details for the logo signage.
 - a. **Owner will provide all signage.**
20. Are some of the ceiling tiles in Conference Rooms A&B to be painted?
 - a. **Yes. See finish schedule and ceiling plan.**
21. There are several items listed on the drawings that do not have a spec section or any specified item listed on the drawings. Please provide specifications for: *list of items*
 - a. --
22. Is there supposed to be a screen around the dumpster? If so, please provide information regarding the screen and installation.
 - a. **No screen required.**
23. Please provide details and sections for the VersaLok retaining wall.
 - a. **TBD**
24. Please clarify if the flooring areas that are existing concrete are to be re-sealed/polished.
 - a. **Finish F-5 is the existing concrete. Concrete to be cleaned of any adhesive, no polishing required.**
25. Please clarify that there is only one type of ceiling tile used throughout the entire space.
 - a. **All areas shown with ceiling tile are one type. Areas/tiles in conference room with shaded tiles are to be painted per finish schedule.**
26. If the owners are taking care of the parking lot, is the owner also providing and installing their own concrete wheelstops?
 - a. **Yes.**
27. On page S 3.1, note 18 states to see detail S 5.1-10. There is no detail S 5.1-10. Please provide Detail S 5.1-10.
 - a. **This is a typo, the correct reference is S 5.2-10.**
28. There is FRP listed in the specifications. Apart from the mop sink, are there any other locations for the FRP?
 - a. **No. Only at the mop sink 24" beyond the leading edge of the fixture.**
29. The sections for room 127 men's and 128 women's restrooms call for solid surface countertops. On the plumbing schedule, they call out undermount sinks. Please clarify that both of these are correct.
 - a. **These are correct.**
30. Is the contractor to assume any required 3rd party testing or requirements to be paid for by the owner?
 - a. **The owner will retain the services of a 3rd party consultant to provide necessary inspections; those services are paid by the owner.**

31. Is there any hardwiring to new owner supplied furniture or just receptacles as indicated on the drawings?
a. **All furniture is plug-style, no hard wiring required.**
32. What is the W- Beam size that supports the operable partition?
a. **Refer to Keyed note 3 on sheet S 3.1.**
33. Are there mechanical demolition drawings?
a. **No. All existing HVAC equipment, devices, ductwork, appurtenances to be removed.**
34. What happens with the existing outdoor unit on the east side and the existing concrete slab?
a. **Slab and unit to be removed, site patched with topsoil and seeded and mulched.**
35. Is all the gas piping on the interior to be demo'd?
a. **Remove back to gas meter and run new as indicated on the plumbing and HVAC plans.**
36. Can we substitute the York HVAC equipment with Bryant/Carrier?
a. **Yes.**

SECTION 084113 - ALUMINUM-FRAMED ENTRANCES AND STOREFRONTS

PART 1 - GENERAL

1.1 SECTION REQUIREMENTS

- A. Submittals: Product Data, Shop Drawings, and color Samples.
 - 1. For entrance doors, include hardware schedule.

PART 2 - PRODUCTS

2.1 PERFORMANCE REQUIREMENTS

- A. Structural Performance: Design, engineer, fabricate, and install aluminum-framed storefronts to withstand structural loads indicated.
 - 1. Limit deflection of framing members normal to wall plane to 1/175 of clear span or an amount that restricts edge deflection of individual glazing lites to 3/4 inch whichever is less.
- B. Structural Testing: Systems tested according to ASTM E 330 at 150 percent of inward and outward wind-load design pressures do not evidence material failures, structural distress, deflection failures, or permanent deformation of main framing members exceeding 0.2 percent of clear span.
- C. Windborne-Debris Resistance: Framing system and doors pass basic protection testing requirements in ASTM E 1996 for Wind Zone 1 when tested according to ASTM E 1886.
- D. Air Infiltration: Limited to 0.06 cfm/sq. ft. of fixed framing and glass area when tested according to ASTM E 283 at a static-air-pressure difference of 1.57 lbf/sq. ft. .
- E. Water Penetration: Systems do not evidence water leakage when tested according to ASTM E 331 at minimum differential pressure of 20 percent of positive wind-load design pressure but not less than 10 lbf/sq. ft.
- F. Thermal Transmittance (U-factor): Fixed glazing and framing areas shall have U-factor of not more than 0.52 Btu/sq. ft. x h x deg F as determined according to NFRC 100.

2.2 ALUMINUM-FRAMED STOREFRONTS

- A. **Basis of Design: Kawneer 451T; Equal products by Tubelite, EFCO.**
- B. Aluminum: Alloy and temper recommended by manufacturer for type of use and finish indicated.

- C. Framing Members: Manufacturer's standard extruded-aluminum framing members of thickness required and reinforced as required to support imposed loads.
 - 1. Construction: Thermally broken.
- D. Doors: 1-3/4-inch thick glazed doors with minimum 0.125-inch thick, extruded-aluminum tubular rail and stile members. Mechanically fasten corners with reinforcing brackets that are deeply penetrated and fillet welded or that incorporate concealed tie rods. Provide snap-on, extruded-aluminum glazing stops and preformed gaskets.
 - 1. **Door Design: Wide stile; 5-inch nominal width. Basis of Design, Kawneer 500 Series.**
 - 2. Accessible Doors: Smooth surfaced for width of door in area within 10 inches above floor or ground plane.
 - 3. Interior Doors: Provide BHMA A156.16 silencers, three on strike jamb of single-door frames and two on head of double-door frames.
 - 4. Exterior Doors: Provide compression weather stripping at fixed stops. At other locations, provide sliding weather stripping retained in adjustable strip mortised into door edge.
 - 5. Hardware: As specified in Door Hardware Schedule on the Drawings.
- E. Glazing: Comply with Section 088000 "Glazing."
- F. Glazing Gaskets: Manufacturer's standard sealed-corner pressure-glazing system of black, resilient elastomeric glazing gaskets, setting blocks, and shims or spacers.
- G. Fasteners and Accessories: Compatible with adjacent materials, corrosion resistant, nonstaining, and nonbleeding. Use concealed fasteners except for application of door hardware.
- H. Fabrication: Fabricate framing in profiles indicated for flush glazing (without projecting stops). Provide subframes and reinforcing of types indicated or, if not indicated, as required for a complete system. Factory-assemble components to greatest extent possible. Disassemble components only as necessary for shipment and installation.
 - 1. Door Framing: Reinforce to support imposed loads. Factory-assemble door and frame units and factory-install hardware to greatest extent possible. Reinforce door and frame units for hardware indicated. Cut, drill, and tap for factory-installed hardware before finishing components.
- I. Aluminum Finish: Class I, clear anodic finish; complying with AAMA 611.

PART 3 - EXECUTION

3.1 INSTALLATION

- A. Isolate metal surfaces in contact with incompatible materials, including wood, by painting contact surfaces with bituminous coating or primer or by applying sealant or tape recommended by manufacturer.

- B. Install components to drain water passing joints, condensation occurring within framing members, and moisture migrating within the system to exterior.
- C. Set continuous sill members and flashing in full sealant bed as specified in Section 079200 "Joint Sealants" to produce weathertight installation.
- D. Install framing components true in alignment with established lines and grades to the following tolerances:
 - 1. Variation from Plane: Limit to 1/8 inch in 12 feet over total length.
 - 2. Alignment: For surfaces abutting in line, limit offset to 1/16 inch. For surfaces meeting at corners, limit offset to 1/32 inch.
 - 3. Diagonal Measurements: Limit difference between diagonal measurements to 1/8 inch.
- E. Install doors without warp or rack. Adjust doors and hardware to provide tight fit at contact points and smooth operation.

END OF SECTION 084113

SECTION 088000 - GLAZING

PART 1 - GENERAL

1.1 SECTION REQUIREMENTS

- A. Submittals: Product Data.

PART 2 - PRODUCTS

2.1 GLASS, GENERAL

- A. Glazing Publications: Comply with published recommendations of glass product manufacturers and organizations below unless more stringent requirements are indicated. See these publications for glazing terms not otherwise defined in this Section or in referenced standards.
- B. Safety Glazing: Where safety glazing is indicated, provide glazing that complies with 16 CFR 1201, Category II.
- C. Safety Glazing Labeling: Where safety glazing is indicated, permanently mark glazing with certification label of the SGCC, the SGCC or another certification agency acceptable to authorities having jurisdiction or manufacturer. Label shall indicate manufacturer's name, type of glass, thickness, and safety glazing standard with which glass complies.
- D. Insulating-Glass Certification Program: Permanently marked either on spacers or on at least one component lite of units with appropriate certification label of IGCC.
- E. Windborne-Debris-Impact Resistance: Exterior glazing shall comply with basic - protection testing requirements in ASTM E 1996 for Wind Zone 1 tested according to ASTM E 1886. Test specimens shall be no smaller in width and length than glazing indicated for use on Project and shall be installed in same manner as glazing indicated for use on Project.

2.2 GLASS PRODUCTS

- A. Annealed Float Glass: ASTM C 1036, Type I, Quality-Q3.
- B. Fully Tempered Float Glass: ASTM C 1048, Kind FT; Type I; Quality-Q3.
- C. Heat-Strengthened Float Glass: ASTM C 1048, Kind HS; Type I; Quality-Q3.
- D. Insulating-Glass Units: Factory-assembled units consisting of sealed lites of glass separated by a dehydrated interspace, qualified according to ASTM E 2190.
- E. Glazing Sealant: Neutral-curing silicone glazing sealant complying with ASTM C 920, Type S, Grade NS, Class 25, Use NT. First "Low-Emitting Materials" Paragraph below is based on LEED-NC and LEED-CI Credit IEQ 4.1 and LEED for Homes Credit MR 2.2.

- F. Low-Emitting Materials: Sealants shall have a VOC content of not more than 250 g/L.

PART 3 - EXECUTION

3.1 INSTALLATION

- A. Comply with combined recommendations of manufacturers of glass, sealants, gaskets, and other glazing materials, unless more stringent requirements are contained in GANA's "Glazing Manual."
- B. Set glass lites in each series with uniform pattern, draw, bow, and similar characteristics.
- C. Remove nonpermanent labels, and clean surfaces immediately after installation.

3.2 MONOLITHIC-GLASS TYPES

- A. Glass Type: Clear annealed or fully tempered where noted, float glass.
 - 1. Thickness: 6 mm.
 - 2. Safety glazing required as indicated on plans.

3.3 INSULATING-GLASS TYPES

- A. Glass Type: Low-E-coated, clear insulating glass.
 - 1. Overall Unit Thickness: 1 inch.
 - 2. Thickness of Each Glass Lite: 4 mm.
 - 3. Outdoor Lite: Annealed or Fully tempered – refer to plans, float glass.
 - 4. Interspace Content: Argon.
 - 5. Indoor Lite: Annealed or Fully tempered – refer to plans, float glass.
 - 6. Visible Light Transmittance: 80 percent minimum.
 - 7. U-Factor: 0.48 maximum.
 - 8. Solar Heat-Gain Coefficient: .25 max.
 - 9. Safety glazing required where noted on plans.
 - 10. Indoor Lite: Clear annealed or fully tempered, refer to plans float glass.


END OF SECTION 088000

New Offices for Morrow County Health District

480 Douglas St. Mt. Gilead, OH 43338



PROJECT
New Offices for
Morrow County Health District
480 Douglas St.
Mt. Gilead, OH 43338

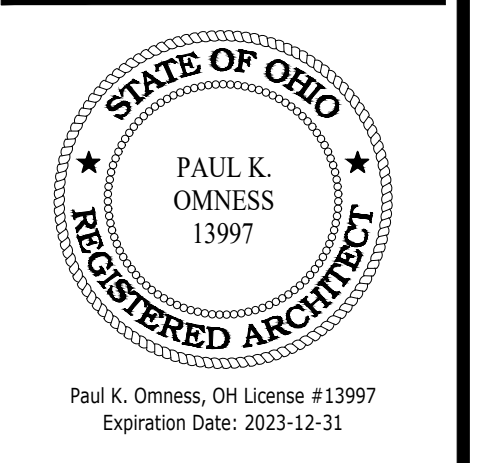


Paul K. Omness, OH License #13997
Expiration Date: 2023-12-31

Project #: 2023-029
Issued For: Permit
Date: 2023-11-06
Revisions:
2024-01-31

SHEET TITLE
Title Sheet
SHEET NUMBER
T1.01

ABBREVIATIONS	GENERAL NOTES	INDEX OF DRAWINGS	PROJECT TEAM																																																																																																																																																																																																																																																																																																																																																																																																								
<table border="0"> <tr><td>A.B.</td><td>ANCHOR BOLT</td><td>D.F.</td><td>DRINKING FOUNTAIN</td><td>HVAC</td><td>HEATING, VENTILATION, AIR CONDITIONING</td><td>R</td><td>RADIUS</td></tr> <tr><td>A.P.</td><td>ACCESS PANEL</td><td>E</td><td>EACH</td><td>HGT</td><td>HEIGHT</td><td>REF</td><td>REFERENCE</td></tr> <tr><td>ACOUS</td><td>ACOUSTICAL</td><td>EA</td><td>EACH</td><td>H.M.</td><td>HOLLOW CORE</td><td>REIN</td><td>REINFORCED</td></tr> <tr><td>A.F.F.</td><td>ABOVE FINISH FLOOR</td><td>ELEC.</td><td>ELECTRICAL</td><td>H.C.</td><td>HOLLOW CORE</td><td>REQD</td><td>REQUIRED</td></tr> <tr><td>ADJ</td><td>ADJACENT</td><td>E.W.C.</td><td>ELECTRIC WATER COOLER</td><td>H.M.</td><td>HOLLOW METAL</td><td>RES</td><td>RESILIENT</td></tr> <tr><td>AGGR</td><td>AGGREGATE</td><td>E.P.</td><td>ELECTRICAL PANEL BOARD</td><td>HR</td><td>HOUR</td><td>R.A.</td><td>RETURN AIR</td></tr> <tr><td>A.C.</td><td>AIR CONDITIONING</td><td>EL. ELEV</td><td>ELEVATION</td><td>INCL</td><td>INCLUDE</td><td>R.H.</td><td>RIGHT HAND</td></tr> <tr><td>ALT</td><td>ALTERNATE</td><td>EL. ELEV</td><td>ELEVATOR</td><td>ID.</td><td>INSIDE DIAMETER</td><td>R.O.W.</td><td>RIGHT OF WAY</td></tr> <tr><td>ALUM</td><td>ALUMINUM</td><td>EMER</td><td>EMERGENCY</td><td>INSUL</td><td>INSULATION</td><td>R</td><td>RISER</td></tr> <tr><td>L</td><td>ANGLE</td><td>EQ</td><td>EQUAL</td><td>INT</td><td>INTERIOR</td><td>R.D.</td><td>ROOF DRAIN</td></tr> <tr><td>APPD</td><td>APPROVED</td><td>EQPT</td><td>EQUIPMENT</td><td>JT</td><td>JOINT</td><td>RM</td><td>ROOM</td></tr> <tr><td>APPROX</td><td>APPROXIMATE</td><td>EXIS. EXG</td><td>EXISTING</td><td>L.H.</td><td>LEFT HAND</td><td>R.O.</td><td>ROUGH OPENING</td></tr> <tr><td>ARCH</td><td>ARCHITECTURAL</td><td>EXP</td><td>EXPANSION</td><td>LGTH</td><td>LENGTH</td><td>SECT</td><td>SECTION</td></tr> <tr><td>A.D.</td><td>AREA DRAIN</td><td>E.J.</td><td>EXPANSION JOINT</td><td>LTL</td><td>LENGTH</td><td>SCHED</td><td>SCHEDULE</td></tr> <tr><td>ASPH</td><td>ASPHALT</td><td>EXPO</td><td>EXPOSED</td><td>M/E/P</td><td>MECHANICAL, ELECTRICAL & PLUMBING</td><td>SHTG</td><td>SHEATHING</td></tr> <tr><td>@</td><td>AT</td><td>EXT</td><td>EXTERIOR</td><td>MFR</td><td>MANUFACTURER</td><td>SHT</td><td>SHEET</td></tr> <tr><td>BRG</td><td>BEARING</td><td>F.O.C.</td><td>FACE OF CONCRETE</td><td>MAS</td><td>MASONRY</td><td>SH</td><td>SHELL</td></tr> <tr><td>BM</td><td>BEAM</td><td>F.O.F.</td><td>FACE OF FINISH</td><td>M.O.</td><td>MASONRY OPENING</td><td>SM</td><td>SIMILAR</td></tr> <tr><td>BTUM</td><td>BITUMINOUS</td><td>F.O.S.</td><td>FACE OF STUD</td><td>M.</td><td>MATERIAL</td><td>S.C.</td><td>SOLID CORE</td></tr> <tr><td>BLK</td><td>BLOCK</td><td>FIN</td><td>FINISH</td><td>MTL</td><td>METAL</td><td>S</td><td>SOUTH</td></tr> <tr><td>BLKG</td><td>BLOCKING</td><td>F.A.</td><td>FIRE ALARM</td><td>MAX</td><td>MAXIMUM</td><td>S.F.</td><td>SQUARE FEET or FOOT</td></tr> <tr><td>BD</td><td>BOARD</td><td>F.A.E.</td><td>FIRE EXTINGUISHER</td><td>MECH</td><td>MECHANICAL</td><td>SPEC</td><td>SPECIFICATIONS</td></tr> <tr><td>B.O.</td><td>BOTTOM OF</td><td>F.E.C.</td><td>FIRE EXTINGUISHER CABINET</td><td>MEMB</td><td>MEMBRANE</td><td>SG</td><td>SQUARE</td></tr> <tr><td>BOT</td><td>BOTTOM</td><td>FRFP</td><td>FIREPROOF</td><td>MTL</td><td>METAL</td><td>S.S.</td><td>SOLID SURFACE</td></tr> <tr><td>BLDG</td><td>BUILDING</td><td>FLG</td><td>FLASHING</td><td>MN</td><td>MINIMUM</td><td>SST</td><td>STAINLESS STEEL</td></tr> <tr><td>C.B.</td><td>CATCH BASIN</td><td>F.B.</td><td>FLAT BAR</td><td>MSC</td><td>MISCELLANEOUS</td><td>STD</td><td>STANDARD</td></tr> <tr><td>CEM</td><td>CEMENT</td><td>FL</td><td>FLOOR</td><td>MTD</td><td>MOUNTED</td><td>STL</td><td>STEEL</td></tr> <tr><td>C.J.</td><td>CONTROL JOINT</td><td>F.D.</td><td>FLOOR DRAIN</td><td>MIL</td><td>MILLION</td><td>STRUCT</td><td>STRUCTURAL</td></tr> <tr><td>CLG</td><td>CAULKING</td><td>FLUR</td><td>FLUORESCENT</td><td>NOM</td><td>NOMINAL</td><td>SYM</td><td>SYMMETRICAL</td></tr> <tr><td>CLG</td><td>CEILING</td><td>FT</td><td>FOOT or FEET</td><td>N</td><td>NORTH</td><td>TEL</td><td>TELEPHONE</td></tr> <tr><td>CLR</td><td>CLEAR</td><td>FTG</td><td>FOOTING</td><td>N.I.C.</td><td>NOT IN CONTRACT</td><td>THK</td><td>THICK</td></tr> <tr><td>C.M.U.</td><td>CONCRETE MASONRY UNIT</td><td>FDN</td><td>FOUNDATION</td><td>N.T.S.</td><td>NOT TO SCALE</td><td>T.C.</td><td>TOP OF CURB</td></tr> <tr><td>C.O.</td><td>CLEAN OUT</td><td>FRM</td><td>FRAME</td><td>NO or #</td><td>NUMBER</td><td>T.O.</td><td>TOP OF</td></tr> <tr><td>CTR</td><td>CENTER</td><td>FRMG</td><td>FRAMING</td><td>O.C.</td><td>ON CENTER</td><td>T.O.P.</td><td>TOP OF PAVEMENT</td></tr> <tr><td>CL</td><td>CENTERLINE</td><td>F.R.T.</td><td>FIRE RETARDANT TREATED</td><td>OPNG</td><td>OPENING</td><td>T.O.W.</td><td>TOP OF WALL</td></tr> <tr><td>COL</td><td>COLUMN</td><td>FS</td><td>FILL SIZE</td><td>OPP</td><td>OPPOSITE</td><td>T&G</td><td>TONGUE AND GROOVE</td></tr> <tr><td>CONC</td><td>CONCRETE</td><td>F.S.W.</td><td>FIRE SEPARATION WALL</td><td>OA</td><td>OVERALL</td><td>TP</td><td>TYPICAL</td></tr> <tr><td>CONN</td><td>CONNECTION</td><td>FURR</td><td>FURRING</td><td>O.D.</td><td>OUTSIDE DIMENSION</td><td>UNF</td><td>UNFINISHED</td></tr> <tr><td>CONST</td><td>CONSTRUCTION</td><td>GA</td><td>GAUGE</td><td>P.E.M.B.</td><td>PRE-ENGINEERED METAL BUILDING</td><td>U.N.O.</td><td>UNLESS NOTED OTHERWISE</td></tr> <tr><td>CONTR</td><td>CONTRACTOR</td><td>GALV</td><td>GALVANIZED</td><td>PR</td><td>PAIR</td><td>V.B.</td><td>VAPOR BARRIER</td></tr> <tr><td>CRS</td><td>COURSE</td><td>G.C.</td><td>GENERAL TRADES CONTRACTOR</td><td>PNL</td><td>PANEL</td><td>V.C.T.</td><td>VINYL COMPOSITION TILE</td></tr> <tr><td>DEMO</td><td>DEMOLITION OR DEMOLISH</td><td>GL</td><td>GLASS or GLAZING</td><td>PL</td><td>PLATE</td><td>VERT</td><td>VERTICAL</td></tr> <tr><td>DIL</td><td>DETAIL</td><td>GD</td><td>GRADE, GRADING, GARBAGE</td><td>PLAM</td><td>PLASTIC LAMINATE</td><td>WP</td><td>WATERPROOF</td></tr> <tr><td>DIA</td><td>DIAMETER</td><td>DISP</td><td>DISPOSAL</td><td>PLYWD</td><td>PLYWOOD</td><td>WT</td><td>WEIGHT</td></tr> <tr><td>DNM</td><td>DIMENSION</td><td>GND</td><td>GROUND</td><td>PT</td><td>POINT</td><td>W</td><td>WEST or WIDTH</td></tr> <tr><td>DR</td><td>DOOR</td><td>GYP</td><td>GYPSONUM</td><td>P.S.I.</td><td>POUNDS PER SQUARE INCH</td><td>W/</td><td>WITH</td></tr> <tr><td>D.O.</td><td>DOOR OPENING</td><td>HDW</td><td>HARDWARE</td><td>P.S.F.</td><td>POUNDS PER SQUARE FOOT</td><td>W/O</td><td>WITHOUT</td></tr> <tr><td>DBL</td><td>DOUBLE</td><td>HDR</td><td>HEADER</td><td>P.C.</td><td>PRECAST CONCRETE</td><td>WD</td><td>WOOD</td></tr> <tr><td>DWG</td><td>DRAWING</td><td>HIG</td><td>HEATING</td><td></td><td>or PORTLAND CEMENT</td><td>W.R.B.</td><td>WATER-RESISTIVE BARRIER</td></tr> </table>	A.B.	ANCHOR BOLT	D.F.	DRINKING FOUNTAIN	HVAC	HEATING, VENTILATION, AIR CONDITIONING	R	RADIUS	A.P.	ACCESS PANEL	E	EACH	HGT	HEIGHT	REF	REFERENCE	ACOUS	ACOUSTICAL	EA	EACH	H.M.	HOLLOW CORE	REIN	REINFORCED	A.F.F.	ABOVE FINISH FLOOR	ELEC.	ELECTRICAL	H.C.	HOLLOW CORE	REQD	REQUIRED	ADJ	ADJACENT	E.W.C.	ELECTRIC WATER COOLER	H.M.	HOLLOW METAL	RES	RESILIENT	AGGR	AGGREGATE	E.P.	ELECTRICAL PANEL BOARD	HR	HOUR	R.A.	RETURN AIR	A.C.	AIR CONDITIONING	EL. ELEV	ELEVATION	INCL	INCLUDE	R.H.	RIGHT HAND	ALT	ALTERNATE	EL. ELEV	ELEVATOR	ID.	INSIDE DIAMETER	R.O.W.	RIGHT OF WAY	ALUM	ALUMINUM	EMER	EMERGENCY	INSUL	INSULATION	R	RISER	L	ANGLE	EQ	EQUAL	INT	INTERIOR	R.D.	ROOF DRAIN	APPD	APPROVED	EQPT	EQUIPMENT	JT	JOINT	RM	ROOM	APPROX	APPROXIMATE	EXIS. EXG	EXISTING	L.H.	LEFT HAND	R.O.	ROUGH OPENING	ARCH	ARCHITECTURAL	EXP	EXPANSION	LGTH	LENGTH	SECT	SECTION	A.D.	AREA DRAIN	E.J.	EXPANSION JOINT	LTL	LENGTH	SCHED	SCHEDULE	ASPH	ASPHALT	EXPO	EXPOSED	M/E/P	MECHANICAL, ELECTRICAL & PLUMBING	SHTG	SHEATHING	@	AT	EXT	EXTERIOR	MFR	MANUFACTURER	SHT	SHEET	BRG	BEARING	F.O.C.	FACE OF CONCRETE	MAS	MASONRY	SH	SHELL	BM	BEAM	F.O.F.	FACE OF FINISH	M.O.	MASONRY OPENING	SM	SIMILAR	BTUM	BITUMINOUS	F.O.S.	FACE OF STUD	M.	MATERIAL	S.C.	SOLID CORE	BLK	BLOCK	FIN	FINISH	MTL	METAL	S	SOUTH	BLKG	BLOCKING	F.A.	FIRE ALARM	MAX	MAXIMUM	S.F.	SQUARE FEET or FOOT	BD	BOARD	F.A.E.	FIRE EXTINGUISHER	MECH	MECHANICAL	SPEC	SPECIFICATIONS	B.O.	BOTTOM OF	F.E.C.	FIRE EXTINGUISHER CABINET	MEMB	MEMBRANE	SG	SQUARE	BOT	BOTTOM	FRFP	FIREPROOF	MTL	METAL	S.S.	SOLID SURFACE	BLDG	BUILDING	FLG	FLASHING	MN	MINIMUM	SST	STAINLESS STEEL	C.B.	CATCH BASIN	F.B.	FLAT BAR	MSC	MISCELLANEOUS	STD	STANDARD	CEM	CEMENT	FL	FLOOR	MTD	MOUNTED	STL	STEEL	C.J.	CONTROL JOINT	F.D.	FLOOR DRAIN	MIL	MILLION	STRUCT	STRUCTURAL	CLG	CAULKING	FLUR	FLUORESCENT	NOM	NOMINAL	SYM	SYMMETRICAL	CLG	CEILING	FT	FOOT or FEET	N	NORTH	TEL	TELEPHONE	CLR	CLEAR	FTG	FOOTING	N.I.C.	NOT IN CONTRACT	THK	THICK	C.M.U.	CONCRETE MASONRY UNIT	FDN	FOUNDATION	N.T.S.	NOT TO SCALE	T.C.	TOP OF CURB	C.O.	CLEAN OUT	FRM	FRAME	NO or #	NUMBER	T.O.	TOP OF	CTR	CENTER	FRMG	FRAMING	O.C.	ON CENTER	T.O.P.	TOP OF PAVEMENT	CL	CENTERLINE	F.R.T.	FIRE RETARDANT TREATED	OPNG	OPENING	T.O.W.	TOP OF WALL	COL	COLUMN	FS	FILL SIZE	OPP	OPPOSITE	T&G	TONGUE AND GROOVE	CONC	CONCRETE	F.S.W.	FIRE SEPARATION WALL	OA	OVERALL	TP	TYPICAL	CONN	CONNECTION	FURR	FURRING	O.D.	OUTSIDE DIMENSION	UNF	UNFINISHED	CONST	CONSTRUCTION	GA	GAUGE	P.E.M.B.	PRE-ENGINEERED METAL BUILDING	U.N.O.	UNLESS NOTED OTHERWISE	CONTR	CONTRACTOR	GALV	GALVANIZED	PR	PAIR	V.B.	VAPOR BARRIER	CRS	COURSE	G.C.	GENERAL TRADES CONTRACTOR	PNL	PANEL	V.C.T.	VINYL COMPOSITION TILE	DEMO	DEMOLITION OR DEMOLISH	GL	GLASS or GLAZING	PL	PLATE	VERT	VERTICAL	DIL	DETAIL	GD	GRADE, GRADING, GARBAGE	PLAM	PLASTIC LAMINATE	WP	WATERPROOF	DIA	DIAMETER	DISP	DISPOSAL	PLYWD	PLYWOOD	WT	WEIGHT	DNM	DIMENSION	GND	GROUND	PT	POINT	W	WEST or WIDTH	DR	DOOR	GYP	GYPSONUM	P.S.I.	POUNDS PER SQUARE INCH	W/	WITH	D.O.	DOOR OPENING	HDW	HARDWARE	P.S.F.	POUNDS PER SQUARE FOOT	W/O	WITHOUT	DBL	DOUBLE	HDR	HEADER	P.C.	PRECAST CONCRETE	WD	WOOD	DWG	DRAWING	HIG	HEATING		or PORTLAND CEMENT	W.R.B.	WATER-RESISTIVE BARRIER	<p>A. THE ARCHITECT'S RESPONSIBILITY IS LIMITED TO THE ITEMS SHOWN ON THE ARCHITECTURAL DRAWINGS. OBTAIN ARCHITECT'S SPECIFIC APPROVAL PRIOR TO DEVIATING FROM THE DRAWINGS. FOLLOW THE BEST TRADE PRACTICES AND ENGINEERING FOR THE ITEMS NOT SPECIFICALLY DETAILED AND INDICATED.</p> <p>B. IT IS THE CONTRACTOR'S SOLE RESPONSIBILITY TO FOLLOW ALL APPLICABLE SAFETY CODES AND REGULATIONS DURING ALL PHASES OF CONSTRUCTION.</p> <p>C. PROVIDE ADEQUATE TEMPORARY SUPPORT FOR WORK BEING CUT AND PATCHED TO PREVENT FAILURE. DO NOT ENDANGER OTHER WORK. PROVIDE ADEQUATE PROTECTION OF OTHER WORK DURING CUTTING AND PATCHING TO PREVENT DAMAGE. CUT WORK BY METHODS LEAST LIKELY TO DAMAGE WORK TO BE RETAINED AND WORK ADJOINING.</p> <p>D. ALL DIMENSIONS SHALL BE VERIFIED AT THE JOB BY THE GENERAL CONTRACTOR AND EACH SUB-CONTRACTOR. THE ARCHITECT MUST BE NOTIFIED OF ANY DISCREPANCIES BEFORE PROCEEDING WITH THE WORK.</p> <p>E. DIMENSIONS ARE WITNESSED TO FACE OF MASONRY OR TO FACE OF STUD UNLESS OTHERWISE NOTED.</p> <p>F. DETAILS SHOWN ON THE ARCHITECTURAL DRAWINGS ARE PART OF THE STRUCTURAL REQUIREMENTS.</p> <p>G. CONSTRUCTION JOINTS PERMITTED ONLY WHERE SHOWN OR AS APPROVED BY THE ARCHITECT.</p> <p>H. ALL CONNECTIONS ARE TO DEVELOP THE FULL STRENGTH OF THE FRAMING MEMBERS UNLESS OTHERWISE APPROVED.</p> <p>I. PROVIDE LINTELS OF ADEQUATE SIZE FOR ANY OPENINGS NOT SPECIFICALLY INDICATED. FOR DUCTWORK, PIPES, LOUVERS, GRILLS, DAMPERS, ETC.</p> <p>J. IN GENERAL, NEW MATERIALS AND MATERIALS FOR REPAIR CONDITIONS, SHALL MATCH SIMILAR ITEMS IN QUALITY, DETAIL, PROFILE, AND FINISH AS THOSE ALREADY BUILT INTO THE WORK.</p> <p>K. COORDINATE LOCATIONS AND/OR ELEVATIONS OF FLOOR DRAINS, REGISTERS, ACCESS PANELS, GRILLES, LOUVERS, CONNECTORS, CABINET UNIT HEATERS, PANELS, ETC., WITH MECHANICAL AND ELECTRICAL CONTRACTORS.</p> <p>L. SIZE AND LOCATION OF ALL FLOOR, WALL OR ROOF OPENINGS TO BE VERIFIED WITH TRADE AFFECTED BEFORE PROCEEDING WITH WORK.</p> <p>M. THE GENERAL CONTRACTOR SHALL COMPLY WITH ALL BUILDING CODE REQUIREMENTS OF THE LOCAL GOVERNING AUTHORITY, AND SHALL OBTAIN AND PAY FOR ALL REQUIRED PERMITS, FEES, AND INSPECTIONS, WITH THE EXCEPTION OF FEES REQUIRED FOR THE PLUMBING, N.E.A.C., AND ELECTRICAL PORTIONS OF THE WORK, WHICH ARE THE RESPONSIBILITY OF THE RESPECTIVE SUBCONTRACTORS.</p> <p>N. G.C. RESPONSIBLE FOR COORDINATING SMOKE DETECTION SYSTEM ACCEPTANCE TESTS WITH THE BUILDING DEPARTMENT.</p> <p>O. G.C. SHALL PROVIDE A SET OF CONSTRUCTION DOCUMENTS AT THE SITE OF THE WORK AND SHALL BE OPEN FOR INSPECTION BY THE BUILDING OFFICIAL AT ALL TIMES WHILE SUCH WORK IS IN PROGRESS PER OBC 106.3.1</p> <p>P. SPACE SHALL NOT BE OCCUPIED UNTIL THE BUILDING OFFICIAL HAS ISSUED THE CERTIFICATE OF OCCUPANCY.</p> <p>Q. ALL MEANS OF EGRESS DOORS SHALL BE READILY OPENABLE FROM SIDE WHICH EGRESS IS TO BE MADE WITHOUT THE USE OF A KEY OR SPECIAL KNOWLEDGE.</p> <p>R. PRIOR TO ANY EXCAVATION, CONTACT THE OHIO UTILITIES PROTECTION SERVICE (OUPS) AT (800) 362-2764 OR WWW.OUPS.ORG.</p> <p>S. TEMPORARY FACILITIES USED IN CONJUNCTION WITH WORK SHALL BE REMOVED UPON COMPLETION OF PROJECT. G.C. TO COORDINATE PERMITS/REQUIREMENTS WITH BUILDING DEPARTMENT.</p> <p>T. CONTRACTOR SHALL PROVIDE ONE (1) SET OF AS-BUILT DRAWINGS TO THE OWNER AFTER SUBSTANTIAL COMPLETION OF THE PROJECT AND WALK THE OWNER THROUGH NOTES MADE ON THE DRAWINGS THAT DESCRIBE FIELD CHANGES TO THE CONTRACT DOCUMENTS.</p> <p>U. IN THE ABSENCE OF LOCAL, STATE OR FEDERAL LAWS OR ORDINANCES REGULATING CONSTRUCTION SAFETY, THE PROVISIONS OF OBC CHAPTER 33 SHALL GOVERN SAFETY DURING CONSTRUCTION AS WELL AS THE PROTECTION OF ADJACENT PUBLIC AND PRIVATE PROPERTIES.</p> <p>W. ALL EXTERIOR WINDOWS ARE TO BE WEATHER STOPPED AND ALL EXTERIOR DOORS ARE TO BE PROVIDED WITH WEATHERSTRIPPING.</p> <p>X. TEMPERED AND/OR SAFETY GLAZING SHALL BE PROVIDED IN THE FOLLOWING LOCATIONS:</p> <p>X.A. GLAZING IN ALL DOORS (SWINGING, SLIDING AND BIFOLD)</p> <p>X.B. GLAZING IN A FIXED OR OPERABLE PANEL ADJACENT TO A DOOR TO WHICH THE NEAREST VERTICAL EDGE IS WITHIN A 24" ARC OF THE DOOR IN A CLOSED POSITION.</p> <p>X.C. GLAZING IN DOORS AND ENCLOSURES FOR SHOWERS, BATHTUBS, WHIRLPOOLS AND HOT TUBS.</p> <p>X.D. ADDITIONAL LOCATIONS AS INDICATED.</p> <p>X.E. GLAZING ADJACENT TO STAIRWAYS, LANDINGS AND RAMP WITHIN 36" HORIZONTALLY OF A WALKING SURFACE WHEN THE EXPOSED SURFACE OF THE GLAZING IS LESS THAN 40" ABOVE THE PLANE OF THE ADJACENT WALKING SURFACE.</p> <p>X.F. GLAZING ADJACENT TO STAIRWAYS WITHIN 40" HORIZONTALLY OF THE BOTTOM TREAD OF THE STAIRWAY IN ANY DIRECTION WHEN THE EXPOSED SURFACE OF THE GLAZING IS LESS THAN 40" ABOVE THE PLANE OF THE ADJACENT WALKING SURFACE.</p> <p>Y. PROVIDE SOLID BLOCKING AS REQUIRED FOR THE MOUNTING OF CABINETS, PLUMBING FIXTURES, RESTROOM ACCESSORIES, ETC.</p> <p>Z. PROVIDE EDGE STRIPS, REDUCER STRIPS, TRANSITION STRIPS, ETC AT ALL FLOORING MATERIAL TRANSITIONS.</p> <p>AA. PROVIDE MOISTURE RESISTANT GYP BD IN RESTROOMS.</p> <p>AB. PROVIDE CEMENTITIOUS BACKING BOARD AT ALL SURFACES TO RECEIVE WALL TILE.</p>	<p>GENERAL</p> <p>T1.01 TILE SHEET T1.02 ANSI A117.1 T1.03 ANSI A117.1 T1.04 BUILDING CODE DATA</p> <p>ARCHITECTURAL</p> <p>SP.01 SITE PLAN</p> <p>D1.01 DEMOLITION FLOOR PLAN</p> <p>A0.01 LEGENDS & NOTES A1.01 PROPOSED FLOOR PLAN A1.02 PROPOSED FURNITURE PLAN A1.03 PROPOSED ROOF PLAN A1.04 ENLARGED FLOOR PLANS A2.01 PROPOSED CEILING PLAN A2.02 FINISH FLOOR PLAN A2.03 FINISH CEILING PLAN A2.04 INTERIOR ELEVATIONS A2.05 INTERIOR DETAILS A3.01 EXTERIOR ELEVATIONS A4.01 SECTION & DETAILS A4.02 SECTION & DETAILS A5.01 DOOR & WINDOW SCHEDULES & DETAILS A5.02 DOOR & WINDOW DETAILS</p> <p>STRUCTURAL</p> <p>S0.1 GENERAL NOTES S0.2 GENERAL NOTES S1.1 FOUNDATION PLAN S3.1 ROOF FRAMING PLAN S4.1 WALL FRAMING DETAILS S5.1 FOUNDATION DETAILS S5.2 FOUNDATION DETAILS S7.1 FRAMING DETAILS</p> <p>PLUMBING</p> <p>P1.01 PLUMBING DEMOLITION P1.02 SANITARY FLOOR PLAN P1.03 PLUMBING FLOOR PLAN P2.01 PLUMBING SCHEDULES & DETAILS P2.02 PLUMBING ISOMETRIC</p> <p>MECHANICAL</p> <p>M1.01 HVAC FLOOR PLAN M2.01 HVAC SCHEDULES & DETAILS</p> <p>ELECTRICAL</p> <p>E1.01 DEMOLITION FLOOR PLAN E1.02 LIGHTING FLOOR PLAN E1.03 POWER FLOOR PLAN E2.01 ELECTRICAL SCHEDULES E2.02 SINGLE LINE DIAGRAMS PANEL SCHEDULES E2.03 ELECTRICAL SPECIFICATIONS</p>	<p>OWNER: MORROW COUNTY COMMISSIONERS CONTACT: JAMIE BRUCKER 80 N. WALNUT ST. MT. GILEAD, OH 43338 P. 419.718.0759 E. JAMIE.BRUCKER@MORROW.OH.US</p> <p>TRANE: MORROW COUNTY HEALTH DISTRICT CONTACT: STEPHANIE BRAGG 619 W. MARION RD. MT. GILEAD, OH 43338 P. 419.747.1548 ex. 308 E. STEPHANIE.BRAGG@MORROWCOUNTYHEALTH.ORG</p> <p>ARCHITECT: OMNESS DESIGN, INC. CONTACT: PAUL OMNESS 140 FAIRFAX RD. MARION, OH 43302 P. 740.387.8947 E. ODD.PAUL@OMNESSDESIGN.COM</p> <p>STRUCTURAL ENGINEER: DERWACHTER & ASSOCIATES CONTACT: MATT DERWACHTER 5275 MILFORD DR. ZANESVILLE, OH 43701 P. 740.453.9738 E. MATT.DERWACHTER@DERWACHTERASSOCIATES.COM</p> <p>M/E/P ENGINEER: WES ASSOCIATES, INC. CONTACT: TIM BORON 4125 HILLS & DALES RD, NW STE 100 CANTON, OH 43701 P. 330.492.0874</p>
A.B.	ANCHOR BOLT	D.F.	DRINKING FOUNTAIN	HVAC	HEATING, VENTILATION, AIR CONDITIONING	R	RADIUS																																																																																																																																																																																																																																																																																																																																																																																																				
A.P.	ACCESS PANEL	E	EACH	HGT	HEIGHT	REF	REFERENCE																																																																																																																																																																																																																																																																																																																																																																																																				
ACOUS	ACOUSTICAL	EA	EACH	H.M.	HOLLOW CORE	REIN	REINFORCED																																																																																																																																																																																																																																																																																																																																																																																																				
A.F.F.	ABOVE FINISH FLOOR	ELEC.	ELECTRICAL	H.C.	HOLLOW CORE	REQD	REQUIRED																																																																																																																																																																																																																																																																																																																																																																																																				
ADJ	ADJACENT	E.W.C.	ELECTRIC WATER COOLER	H.M.	HOLLOW METAL	RES	RESILIENT																																																																																																																																																																																																																																																																																																																																																																																																				
AGGR	AGGREGATE	E.P.	ELECTRICAL PANEL BOARD	HR	HOUR	R.A.	RETURN AIR																																																																																																																																																																																																																																																																																																																																																																																																				
A.C.	AIR CONDITIONING	EL. ELEV	ELEVATION	INCL	INCLUDE	R.H.	RIGHT HAND																																																																																																																																																																																																																																																																																																																																																																																																				
ALT	ALTERNATE	EL. ELEV	ELEVATOR	ID.	INSIDE DIAMETER	R.O.W.	RIGHT OF WAY																																																																																																																																																																																																																																																																																																																																																																																																				
ALUM	ALUMINUM	EMER	EMERGENCY	INSUL	INSULATION	R	RISER																																																																																																																																																																																																																																																																																																																																																																																																				
L	ANGLE	EQ	EQUAL	INT	INTERIOR	R.D.	ROOF DRAIN																																																																																																																																																																																																																																																																																																																																																																																																				
APPD	APPROVED	EQPT	EQUIPMENT	JT	JOINT	RM	ROOM																																																																																																																																																																																																																																																																																																																																																																																																				
APPROX	APPROXIMATE	EXIS. EXG	EXISTING	L.H.	LEFT HAND	R.O.	ROUGH OPENING																																																																																																																																																																																																																																																																																																																																																																																																				
ARCH	ARCHITECTURAL	EXP	EXPANSION	LGTH	LENGTH	SECT	SECTION																																																																																																																																																																																																																																																																																																																																																																																																				
A.D.	AREA DRAIN	E.J.	EXPANSION JOINT	LTL	LENGTH	SCHED	SCHEDULE																																																																																																																																																																																																																																																																																																																																																																																																				
ASPH	ASPHALT	EXPO	EXPOSED	M/E/P	MECHANICAL, ELECTRICAL & PLUMBING	SHTG	SHEATHING																																																																																																																																																																																																																																																																																																																																																																																																				
@	AT	EXT	EXTERIOR	MFR	MANUFACTURER	SHT	SHEET																																																																																																																																																																																																																																																																																																																																																																																																				
BRG	BEARING	F.O.C.	FACE OF CONCRETE	MAS	MASONRY	SH	SHELL																																																																																																																																																																																																																																																																																																																																																																																																				
BM	BEAM	F.O.F.	FACE OF FINISH	M.O.	MASONRY OPENING	SM	SIMILAR																																																																																																																																																																																																																																																																																																																																																																																																				
BTUM	BITUMINOUS	F.O.S.	FACE OF STUD	M.	MATERIAL	S.C.	SOLID CORE																																																																																																																																																																																																																																																																																																																																																																																																				
BLK	BLOCK	FIN	FINISH	MTL	METAL	S	SOUTH																																																																																																																																																																																																																																																																																																																																																																																																				
BLKG	BLOCKING	F.A.	FIRE ALARM	MAX	MAXIMUM	S.F.	SQUARE FEET or FOOT																																																																																																																																																																																																																																																																																																																																																																																																				
BD	BOARD	F.A.E.	FIRE EXTINGUISHER	MECH	MECHANICAL	SPEC	SPECIFICATIONS																																																																																																																																																																																																																																																																																																																																																																																																				
B.O.	BOTTOM OF	F.E.C.	FIRE EXTINGUISHER CABINET	MEMB	MEMBRANE	SG	SQUARE																																																																																																																																																																																																																																																																																																																																																																																																				
BOT	BOTTOM	FRFP	FIREPROOF	MTL	METAL	S.S.	SOLID SURFACE																																																																																																																																																																																																																																																																																																																																																																																																				
BLDG	BUILDING	FLG	FLASHING	MN	MINIMUM	SST	STAINLESS STEEL																																																																																																																																																																																																																																																																																																																																																																																																				
C.B.	CATCH BASIN	F.B.	FLAT BAR	MSC	MISCELLANEOUS	STD	STANDARD																																																																																																																																																																																																																																																																																																																																																																																																				
CEM	CEMENT	FL	FLOOR	MTD	MOUNTED	STL	STEEL																																																																																																																																																																																																																																																																																																																																																																																																				
C.J.	CONTROL JOINT	F.D.	FLOOR DRAIN	MIL	MILLION	STRUCT	STRUCTURAL																																																																																																																																																																																																																																																																																																																																																																																																				
CLG	CAULKING	FLUR	FLUORESCENT	NOM	NOMINAL	SYM	SYMMETRICAL																																																																																																																																																																																																																																																																																																																																																																																																				
CLG	CEILING	FT	FOOT or FEET	N	NORTH	TEL	TELEPHONE																																																																																																																																																																																																																																																																																																																																																																																																				
CLR	CLEAR	FTG	FOOTING	N.I.C.	NOT IN CONTRACT	THK	THICK																																																																																																																																																																																																																																																																																																																																																																																																				
C.M.U.	CONCRETE MASONRY UNIT	FDN	FOUNDATION	N.T.S.	NOT TO SCALE	T.C.	TOP OF CURB																																																																																																																																																																																																																																																																																																																																																																																																				
C.O.	CLEAN OUT	FRM	FRAME	NO or #	NUMBER	T.O.	TOP OF																																																																																																																																																																																																																																																																																																																																																																																																				
CTR	CENTER	FRMG	FRAMING	O.C.	ON CENTER	T.O.P.	TOP OF PAVEMENT																																																																																																																																																																																																																																																																																																																																																																																																				
CL	CENTERLINE	F.R.T.	FIRE RETARDANT TREATED	OPNG	OPENING	T.O.W.	TOP OF WALL																																																																																																																																																																																																																																																																																																																																																																																																				
COL	COLUMN	FS	FILL SIZE	OPP	OPPOSITE	T&G	TONGUE AND GROOVE																																																																																																																																																																																																																																																																																																																																																																																																				
CONC	CONCRETE	F.S.W.	FIRE SEPARATION WALL	OA	OVERALL	TP	TYPICAL																																																																																																																																																																																																																																																																																																																																																																																																				
CONN	CONNECTION	FURR	FURRING	O.D.	OUTSIDE DIMENSION	UNF	UNFINISHED																																																																																																																																																																																																																																																																																																																																																																																																				
CONST	CONSTRUCTION	GA	GAUGE	P.E.M.B.	PRE-ENGINEERED METAL BUILDING	U.N.O.	UNLESS NOTED OTHERWISE																																																																																																																																																																																																																																																																																																																																																																																																				
CONTR	CONTRACTOR	GALV	GALVANIZED	PR	PAIR	V.B.	VAPOR BARRIER																																																																																																																																																																																																																																																																																																																																																																																																				
CRS	COURSE	G.C.	GENERAL TRADES CONTRACTOR	PNL	PANEL	V.C.T.	VINYL COMPOSITION TILE																																																																																																																																																																																																																																																																																																																																																																																																				
DEMO	DEMOLITION OR DEMOLISH	GL	GLASS or GLAZING	PL	PLATE	VERT	VERTICAL																																																																																																																																																																																																																																																																																																																																																																																																				
DIL	DETAIL	GD	GRADE, GRADING, GARBAGE	PLAM	PLASTIC LAMINATE	WP	WATERPROOF																																																																																																																																																																																																																																																																																																																																																																																																				
DIA	DIAMETER	DISP	DISPOSAL	PLYWD	PLYWOOD	WT	WEIGHT																																																																																																																																																																																																																																																																																																																																																																																																				
DNM	DIMENSION	GND	GROUND	PT	POINT	W	WEST or WIDTH																																																																																																																																																																																																																																																																																																																																																																																																				
DR	DOOR	GYP	GYPSONUM	P.S.I.	POUNDS PER SQUARE INCH	W/	WITH																																																																																																																																																																																																																																																																																																																																																																																																				
D.O.	DOOR OPENING	HDW	HARDWARE	P.S.F.	POUNDS PER SQUARE FOOT	W/O	WITHOUT																																																																																																																																																																																																																																																																																																																																																																																																				
DBL	DOUBLE	HDR	HEADER	P.C.	PRECAST CONCRETE	WD	WOOD																																																																																																																																																																																																																																																																																																																																																																																																				
DWG	DRAWING	HIG	HEATING		or PORTLAND CEMENT	W.R.B.	WATER-RESISTIVE BARRIER																																																																																																																																																																																																																																																																																																																																																																																																				
<p>SYMBOLS</p> <p> CODED NOTE REVISION NUMBER DOOR TAG DETAIL NUMBER SHEET NUMBER BUILDING SECTION WALL SECTION WINDOW TAG WALL TAG ROOM NUMBER </p> <p>NOTE: MATERIAL & SYMBOLS ARE OFFICE STANDARDS & ARE NOT ALL NECESSARILY INCLUDED.</p>	<p>VICINITY PLAN</p>																																																																																																																																																																																																																																																																																																																																																																																																										

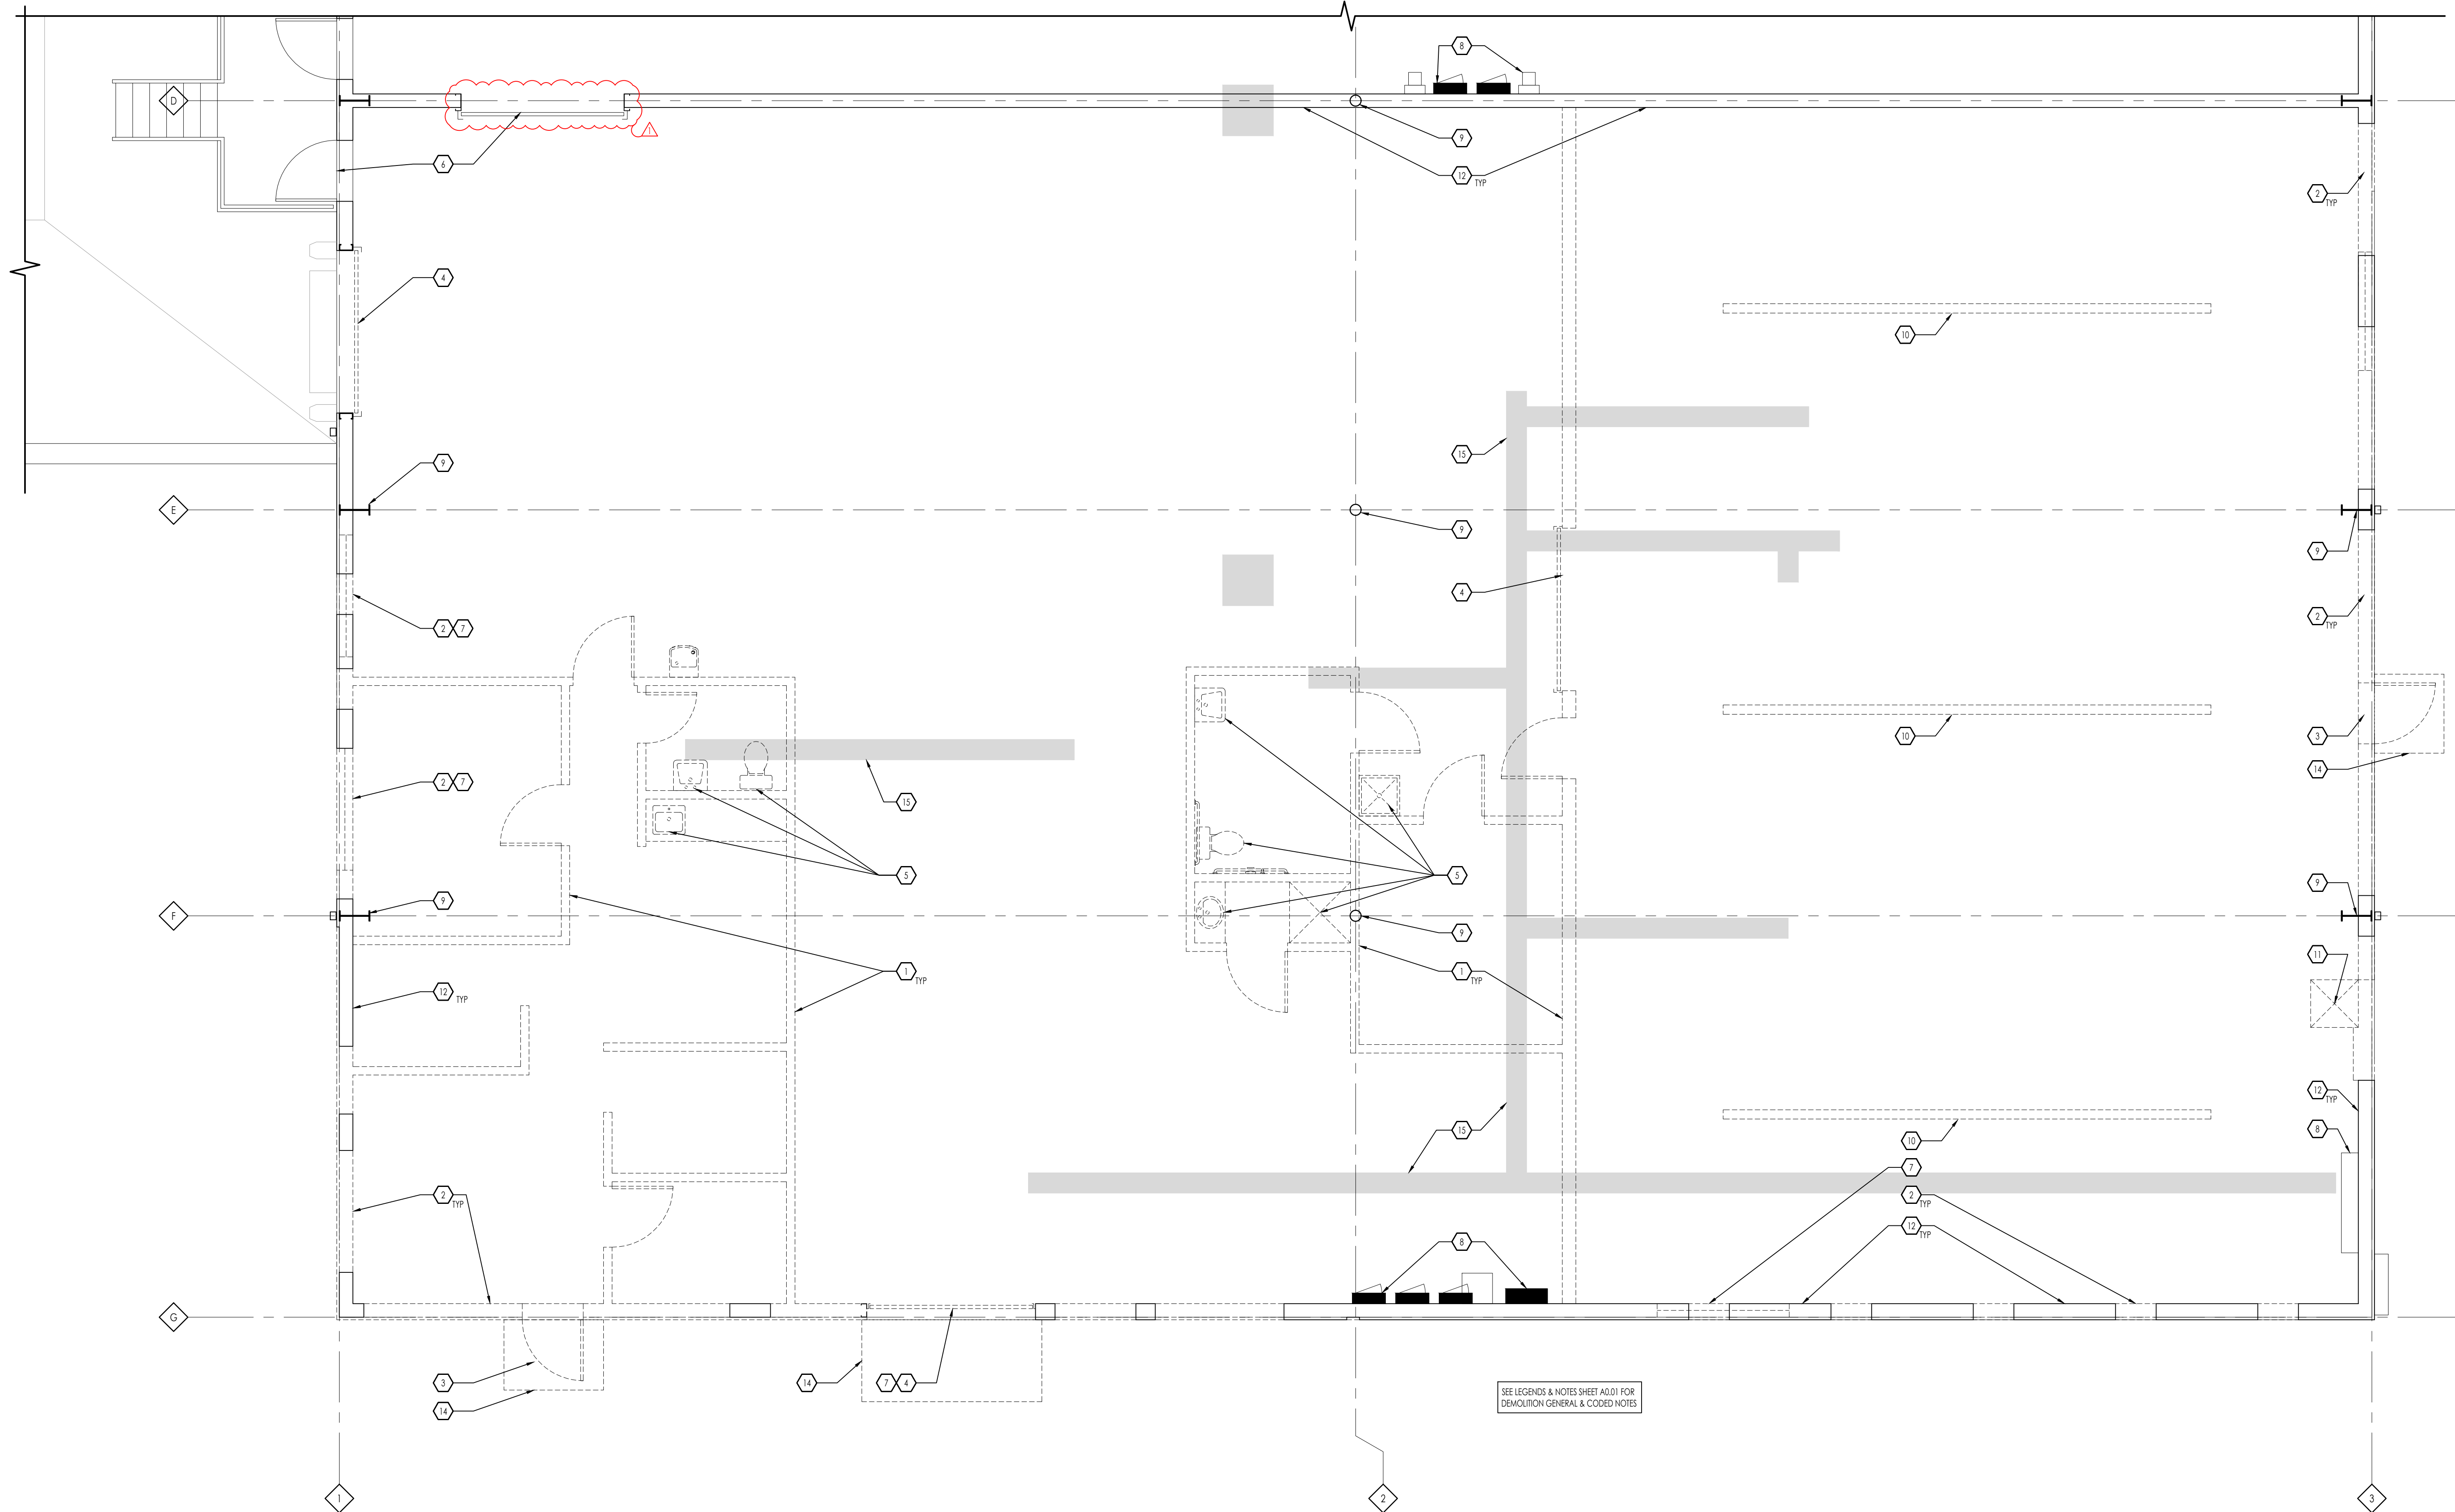


SEE LEGENDS & NOTES SHEET A0.01 FOR DEMOLITION GENERAL & CODED NOTES

A Demolition Floor Plan $\frac{1}{4"} = 1'-0"$

© 2023 Omness Design, Inc.
 The use of these drawings is limited to the client for the subject project. Common law copyright reserved by architect. No part of this document, including modifications thereto, may be reproduced in any form by any means or used for any purpose without written permission of Omness Design, Inc.

SHEET INFORMATION

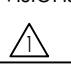Project #:	2023-029
Issued For:	Permit
Date:	2023-11-06
Revisions:	
	2024-01-31



SHEET TITLE

Demolition Floor Plan

SHEET NUMBER

D1.01

LATERAL BRACING FOR SUSPENDED CEILING MUST BE PROVIDED PER CODE REQUIREMENTS WHERE CEILING LOADS ARE LESS THAN 5# PER FT. AND NOT SUPPORTING INTERIOR PARTITIONS. CEILING BRACING SHALL BE PROVIDED BY (4) #12 GAUGE WIRES SECURED TO THE MAIN RUNNER WITHIN 2' OF THE CROSS RUNNER INTERSECTIONS AND SPAYED TO 90 DEGREES FROM THE PLANE OF THE CEILING. THESE HORIZONTAL RESTRAINT POINTS SHALL BE PLACED AT 12'-0" O.C. IN BOTH DIRECTIONS, WITH THE FIRST POINT WITHIN 4'-0" FROM EACH WALL. ATTACHMENT OF THE RESTRAINT WIRES TO THE STRUCTURE ABOVE SHALL BE ADEQUATE FOR THE LOAD IMPOSED.

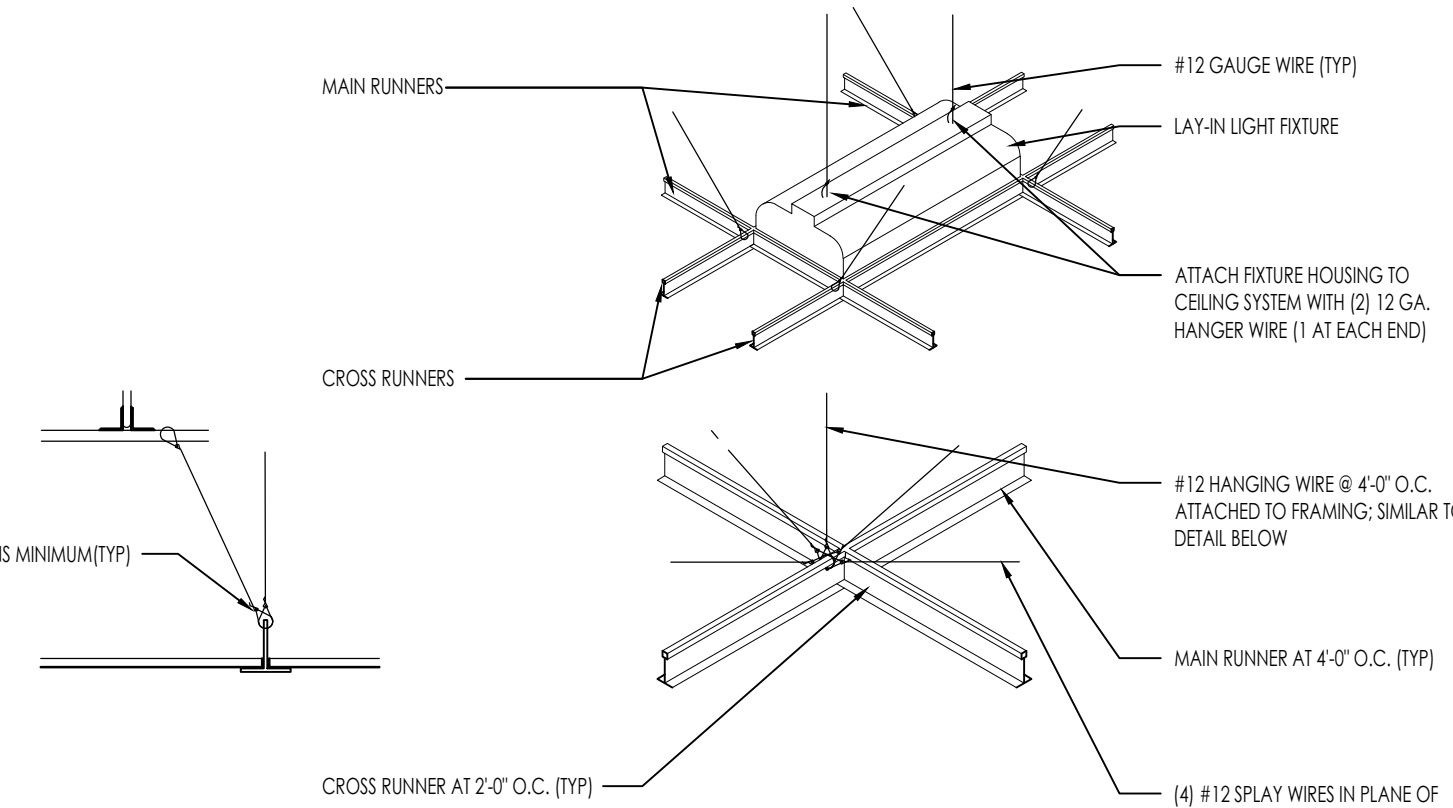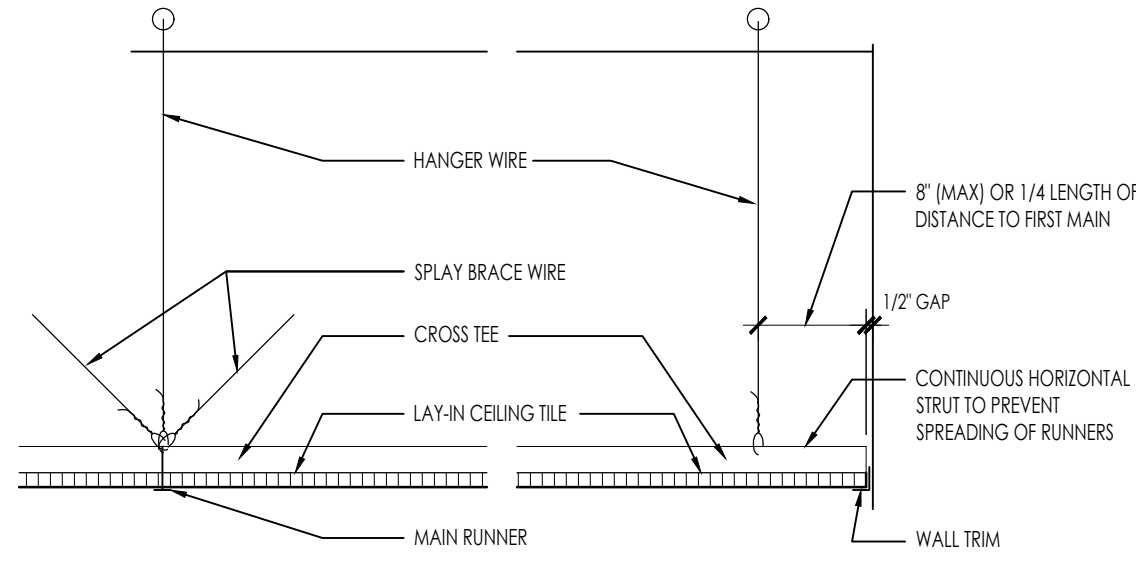


A Drop-In Ceiling Detail
1" = 1'-0"

- RCP CODED NOTES** (SEE SHEET A2.01)
- NEW SUSPENDED A.C.T. AND GRID CEILING - REFER TO DETAILS.
 - G.W.B. BULKHEAD, CEILING OR SOFFIT AREA
 - ACOUSTIC TILE GRID STAIR: CENTER IN ROOM IF NOT NOTED TYPICAL.
 - EGRESS EXIT INDICATOR LIGHT WITH BATTERY BACKUP.
 - CEILING TRACK FOR MOVEABLE PARTITION: SEE DETAILS AND STRUCTURAL.
 - MAINTAIN ALIGNMENT OF CEILING GRID EACH SIDE OF TRACK.
 - SOFFIT ABOVE CABINETS: SEE CASEWORK DETAILS AND CEILING DETAILS FOR HEIGHT AND CONFIGURATION.
 - PAINT EXPOSED FRAMING & DUCT IN THIS AREA PER FINISH SCHEDULE.
 - SHADED AREA INDICATES R-13 UNFACED BATT SOUND ATTENUATION INSULATION TO 24" INSIDE ROOM (TYP).
 - EXISTING EXPOSED ROOF FRAMING AND DUCT TO REMAIN UNFINISHED THIS AREA.
 - DASHED LINES INDICATE OVERHEAD GLASS DOOR AREA. COORDINATE TRACK FRAMING WITH LIGHTING AND HVAC.
 - AHU ABOVE: SEE STRUCTURAL FOR SUPPORT FROM ROOF FRAMING ABOVE: G.C. ALTERNATE TO SUPPORT FROM WALL BRACING WITH ISOLATORS
 - AHU ABOVE: SEE SECTION DETAIL FOR SUPPORT FROM ROOF FRAMING ABOVE CEILING. PREFAB METAL CANOPY: SEE SECTIONS AND ELEVATIONS.
 - CENTER LIGHTING IN ROOM AND SUSPEND AT 10'-0" A.F.F.
 - EXPOSED DUCT


- PLAN CODED NOTES** (SEE SHEET A1.01)
- FACE OF FOUNDATION: SEE STRUCTURAL FOR FURTHER INFORMATION.
 - EXISTING ELECTRICAL EQUIPMENT: REFER TO ELECTRICAL DRAWINGS.
 - FIRE EXTINGUISHER TO BE INSTALLED PER NFPA TO AND ORC 908 - MULTIPURPOSE DRY-CHEMICAL TYPE: UL-RATED 10 LB. NOMINAL CAPACITY, WITH MONODAMMONIUM PHOSPHATE-BASED DRY-CHEMICAL IN MANUFACTURER'S STANDARD DRAINED CONTAINER.
 - PREFINISHED ALUMINUM STOREFRONT SYSTEM: SEE ELEVATIONS AND DOOR AND WINDOW SCHEDULE FOR REQUIREMENTS.
 - EXISTING STRUCTURAL STEEL COLUMN
 - DASHED LINES INDICATE PREFAB AWNING ABOVE: SEE ELEVATIONS AND SECTIONS
 - 4" CONCRETE SLAB ON GRADE ON 15#1 V.B. ON 4" (MIN) COMPACTED AGGREGATE: SEE STRUCTURAL FOR REINFORCING AND PREF REQUIREMENTS.
 - PROVIDE ACCESSIBLE THRESHOLDS AT EACH DOOR LOCATION: SEE DOOR DETAILS
 - ROOF DRAIN DOWNPOUT: SEE ROOF PLAN FOR LOCATIONS AND ROOF DETAILS FOR CONFIGURATION.
 - NEW FIRE EXTINGUISHER
 - PROVIDE PLYWOOD SHEATHING ON FACE OF GYP BD PER ELECTRICAL DRAWINGS FOR TELECOM EQUIPMENT INSTALLATION
 - GAS METER BANK (SHOWN DASHED): SEE PLUMBING PLANS FOR REQUIREMENTS.
 - EXISTING WATER METER BANK: REFER TO MEP DRAWINGS.
 - NEW STRUCTURAL COLUMN: REFER TO DETAILS AND STRUCTURAL DRAWINGS.

- DEMOLITION CODED NOTES** (SEE SHEET D1.01)
- EXISTING INTERIOR WALLS & DOOR (SHOWN DASHED) TO BE REMOVED (TYP)
 - PORTION OF EXISTING EXTERIOR WALL (SHOWN DASHED) TO BE REMOVED. COORDINATE WITH NEW PLANS, ELEVATIONS & DETAILS FOR DOOR AND WINDOW OPENINGS (TYP); SALVAGE EXTERIOR PANELS FOR INRLL & PATCHING REUSE
 - EXISTING EXTERIOR DOOR, FRAME, AND ASSOCIATED AWNING (SHOWN DASHED) TO BE REMOVED
 - EXISTING OVERHEAD DOOR AND TRACK (SHOWN DASHED) TO BE REMOVED
 - EXISTING PLUMBING FIXTURE (SHOWN DASHED) TO BE REMOVED
 - EXISTING DOOR AND FRAME TO REMAIN
 - EXISTING WINDOW ABOVE TO BE REMOVED
 - EXISTING ELECTRICAL PANEL OR EQUIPMENT: SEE ELECTRICAL DRAWINGS
 - EXISTING STRUCTURAL COLUMN TO REMAIN (TYP)
 - REMOVE EXISTING FLOOR DRAIN: SEE PLUMBING PLANS
 - EXISTING MECHANICAL EQUIPMENT (SHOWN DASHED) TO BE REMOVED: SEE HVAC DRAWINGS
 - REMOVE EXISTING INTERIOR METAL PANEL TO ALLOW FOR NEW METAL STUD FRAMING AND GYP BD
 - NOT USED
 - EXISTING CANOPY TO BE REMOVED; PATCH / REPAIR EXTERIOR SIDING AS REQUIRED AND PAINT TO MATCH ADJACENT (SEE ELEVATIONS)
 - SHADED AREA INDICATES APPROXIMATE LOCATION OF SAWCUT IN SLAB FOR PLUMBING AND STRUCTURAL INSTALLATION: V.I.F.

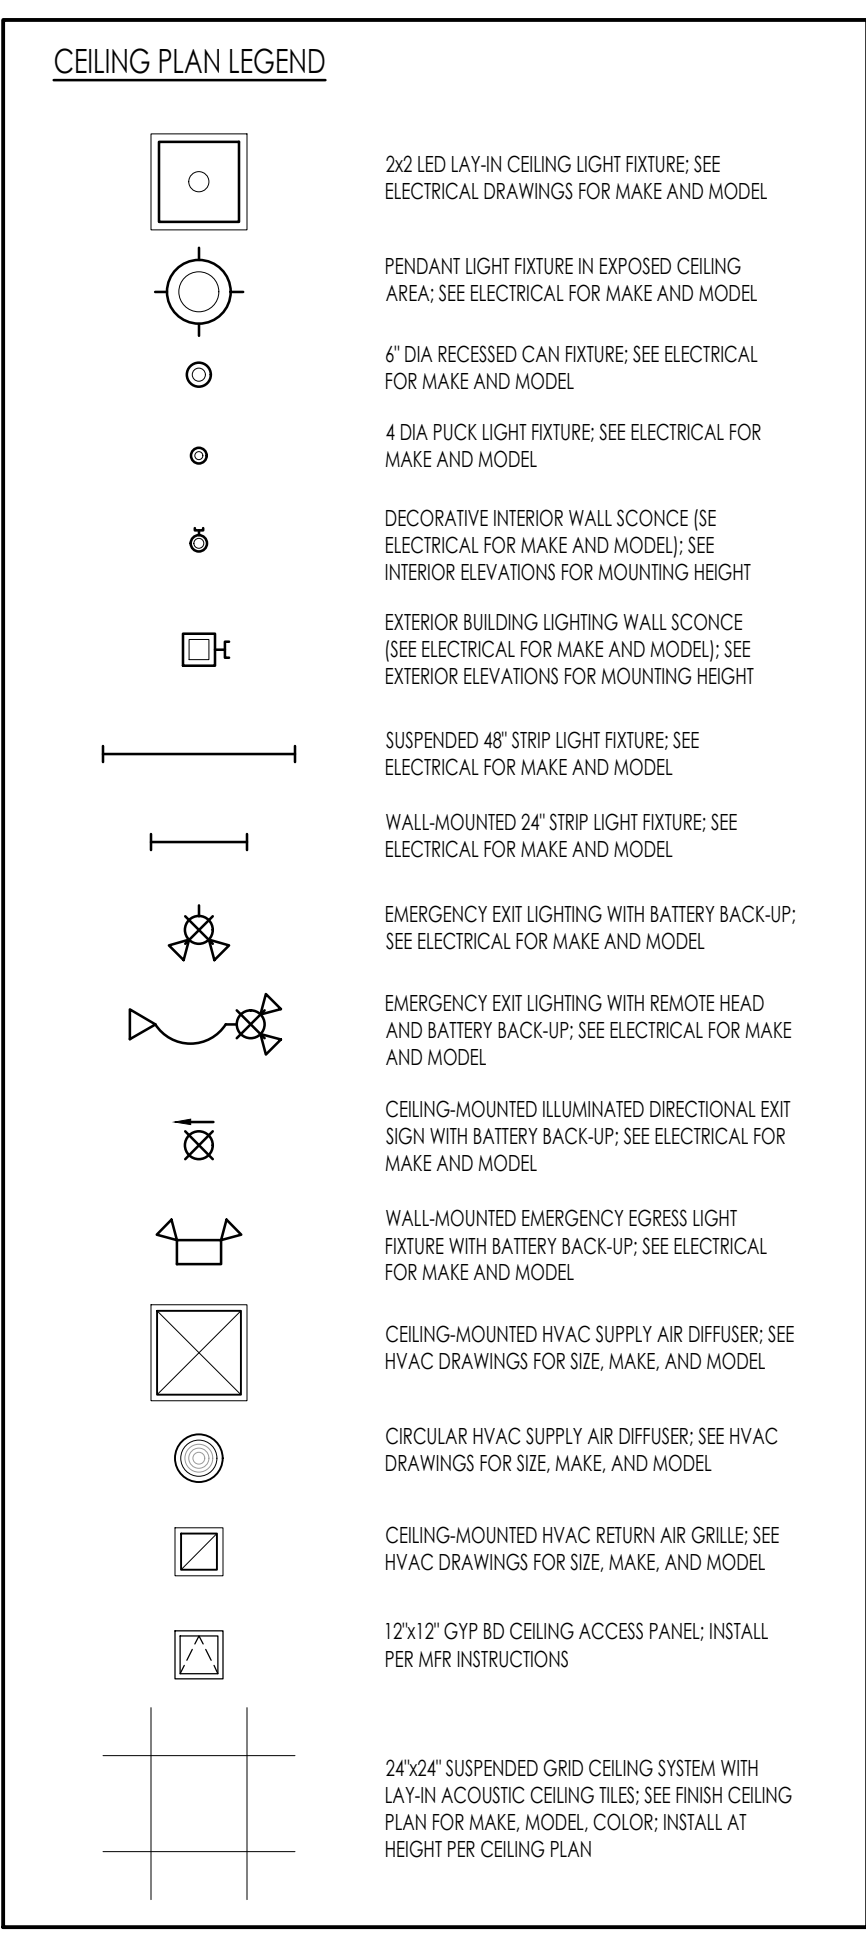

- RCP GENERAL NOTES**
- ALL FIXTURES ARE NEW UNLESS NOTED AS "E" INDICATING EXISTING TO REMAIN; "R" INDICATING RELOCATED FIXTURE.
 - SEE MEP DRAWINGS FOR LOCATION AND TYPE OF SUPPLY & RETURN AIR DIFFUSERS, EXHAUST FANS, THERMOSTATS, AND OTHER RELATED HVAC DEVICES, REQUIREMENTS AND CALCULATIONS.
 - SEE ELECTRICAL DRAWINGS FOR LOCATIONS AND TYPES OF POWER LIGHTING FIXTURES, CIRCUITS, SWITCHES, AND OTHER RELATED ELECTRICAL DEVICES, REQUIREMENTS AND CALCULATIONS.


- GENERAL PLAN NOTES**
- ALL INDICATED DIMENSIONS ON FLOOR PLAN ARE TO FACE OF MASONRY / FACE OF STUD UNLESS NOTED OTHERWISE.
 - PROVIDE CEMENTIOUS BOARD IN LIEU OF DRYWALL AT ALL WALL ASSEMBLIES INDICATED TO RECEIVE TILE AND AT SHOWER LOCATIONS INDICATED TO RECEIVE SOLID SURFACE PANEL OR TILE. PROVIDE VAPOR BARRIER BEHIND BOARD. REFER TO INTERIOR ELEVATIONS AND FINISH NOTES FOR LOCATIONS.
 - DOOR JAMBS TO LOCATE 4" OFF OF ADJACENT WALLS UNLESS NOTED OTHERWISE.
 - G.C. TO COORDINATE ALL REQUIRED MASONRY AND FRAMED ROUGH OPENINGS WITH SELECTED DOORS AND WINDOWS.
 - WALL LEGEND INTENDED TO GIVE A GENERAL OVERVIEW OF SHEATHING MATERIALS. VERIFY ALL SHEATHING MATERIALS AND THICKNESSES W/ SECTIONS AND STRUCTURAL DRAWINGS.
 - COORDINATE REQUIRED CONCRETE BLOCK/BRICK ELEVATIONS AND STEPS W/ SLOPING GRADES. REFER TO CIVIL DRAWINGS AND WALL SECTIONS.
 - REFER TO SPECIFICATIONS AND INTERIOR ELEVATIONS FOR RESTROOM ACCESSORIES; REFER TO PLUMBING DRAWINGS FOR FIXTURE SPECS.
 - ALL INSULATION TO BE EXPOSED TO MEET CLASS A FINISH REQUIREMENTS: FLAME-SPREAD INDEX: 0-25; SMOKE-DEVELOPED INDEX: 0-450

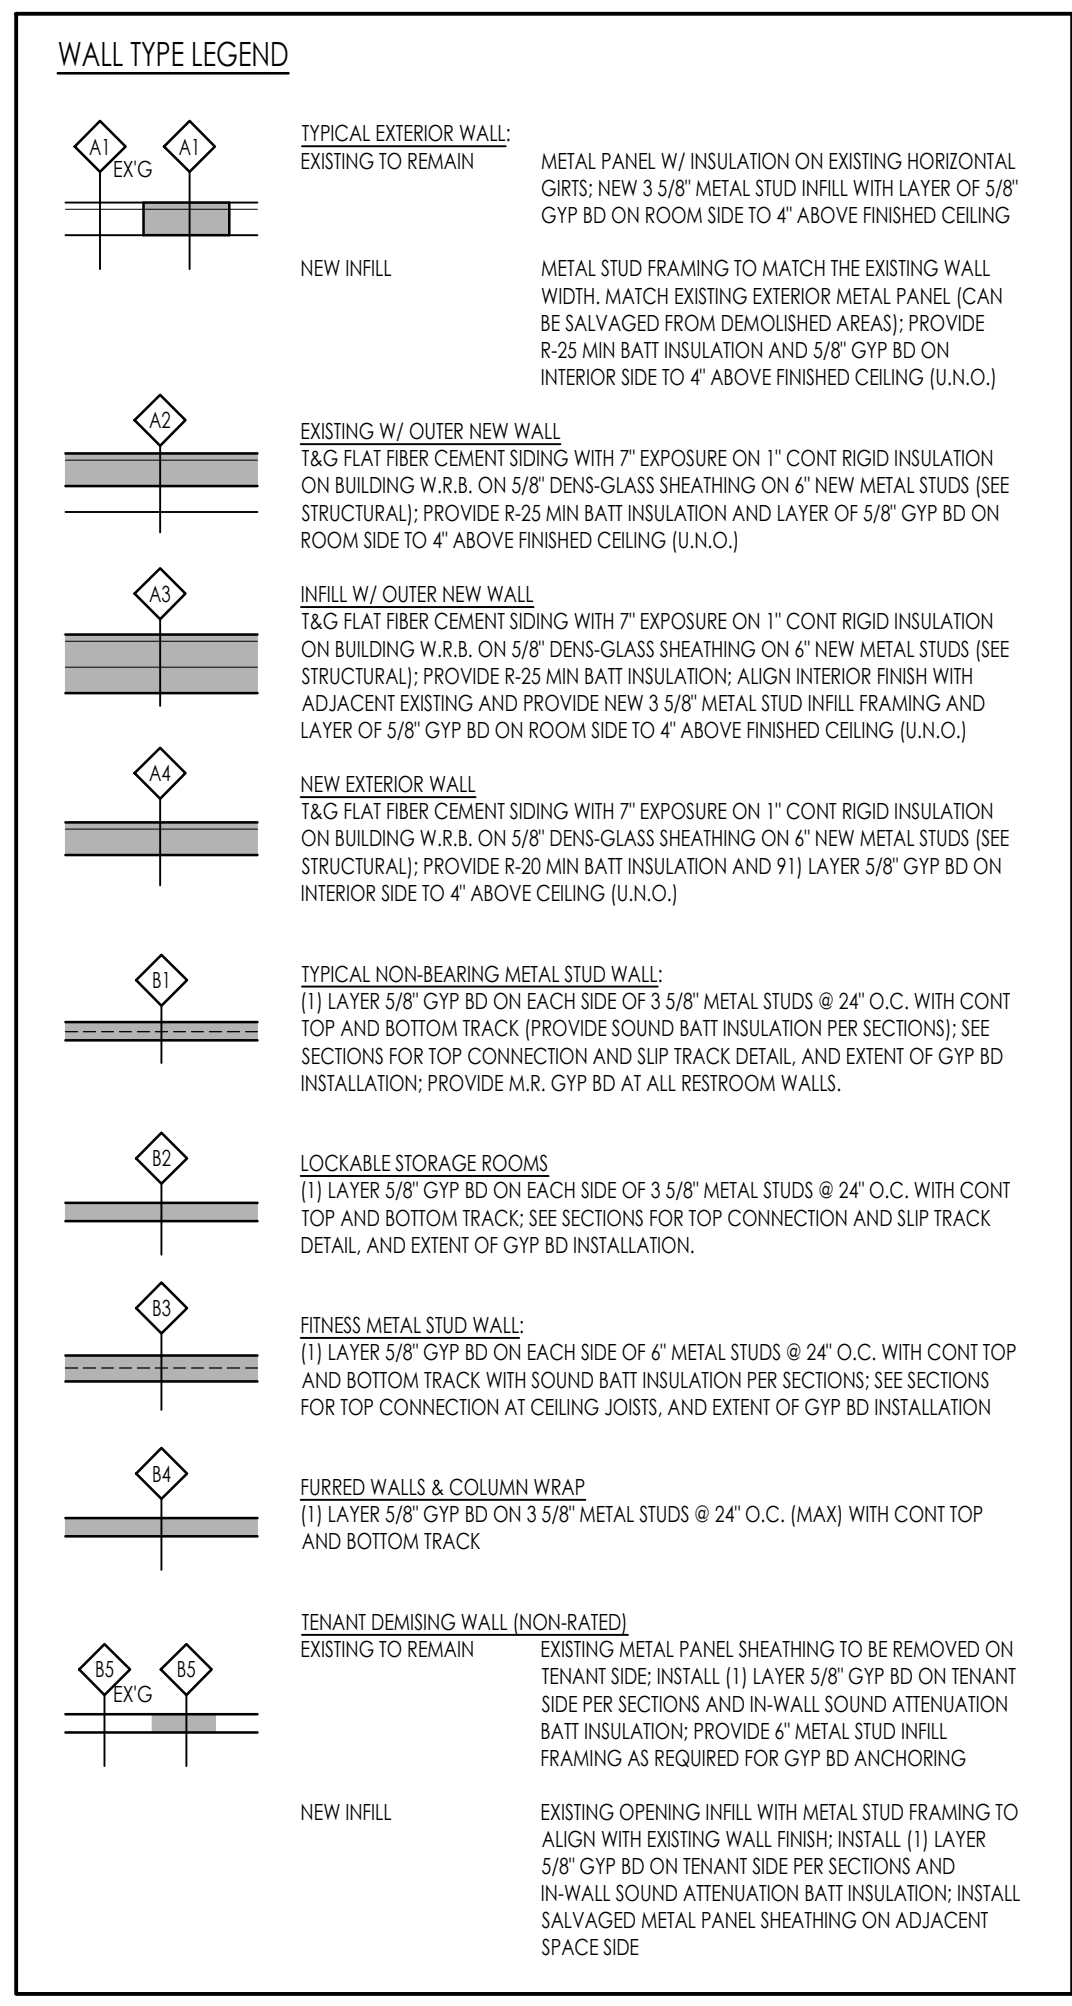

Architect
OMNESS DESIGN, INC.
140 FAIRFAX ROAD
MARION, OHIO 43302



Client
Morrow County Health District
New Offices for
480 Douglas St.
Mt. Glead, OH 43338

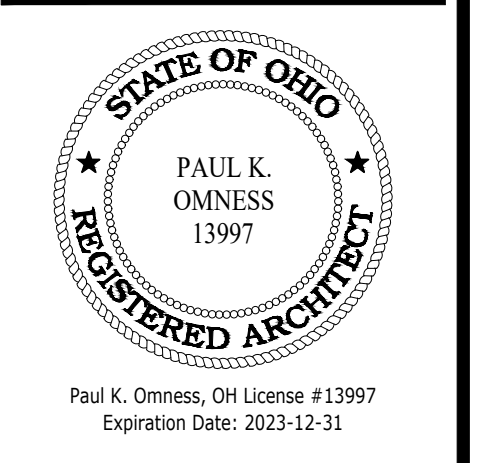


© 2023 Omness Design, Inc.
The use of these drawings is limited to the client for the subject project. Common law copyright reserved by architect. No part of this document, including modifications thereto, may be reproduced in any form for any reason or used for any purpose without written permission of Omness Design, Inc.

SHEET INFORMATION

Project #:	2023-029
Issued For:	Permit
Date:	2023-11-06
Revisions:	2024-01-31


SHEET TITLE
Legends & Notes
SHEET NUMBER
A0.01

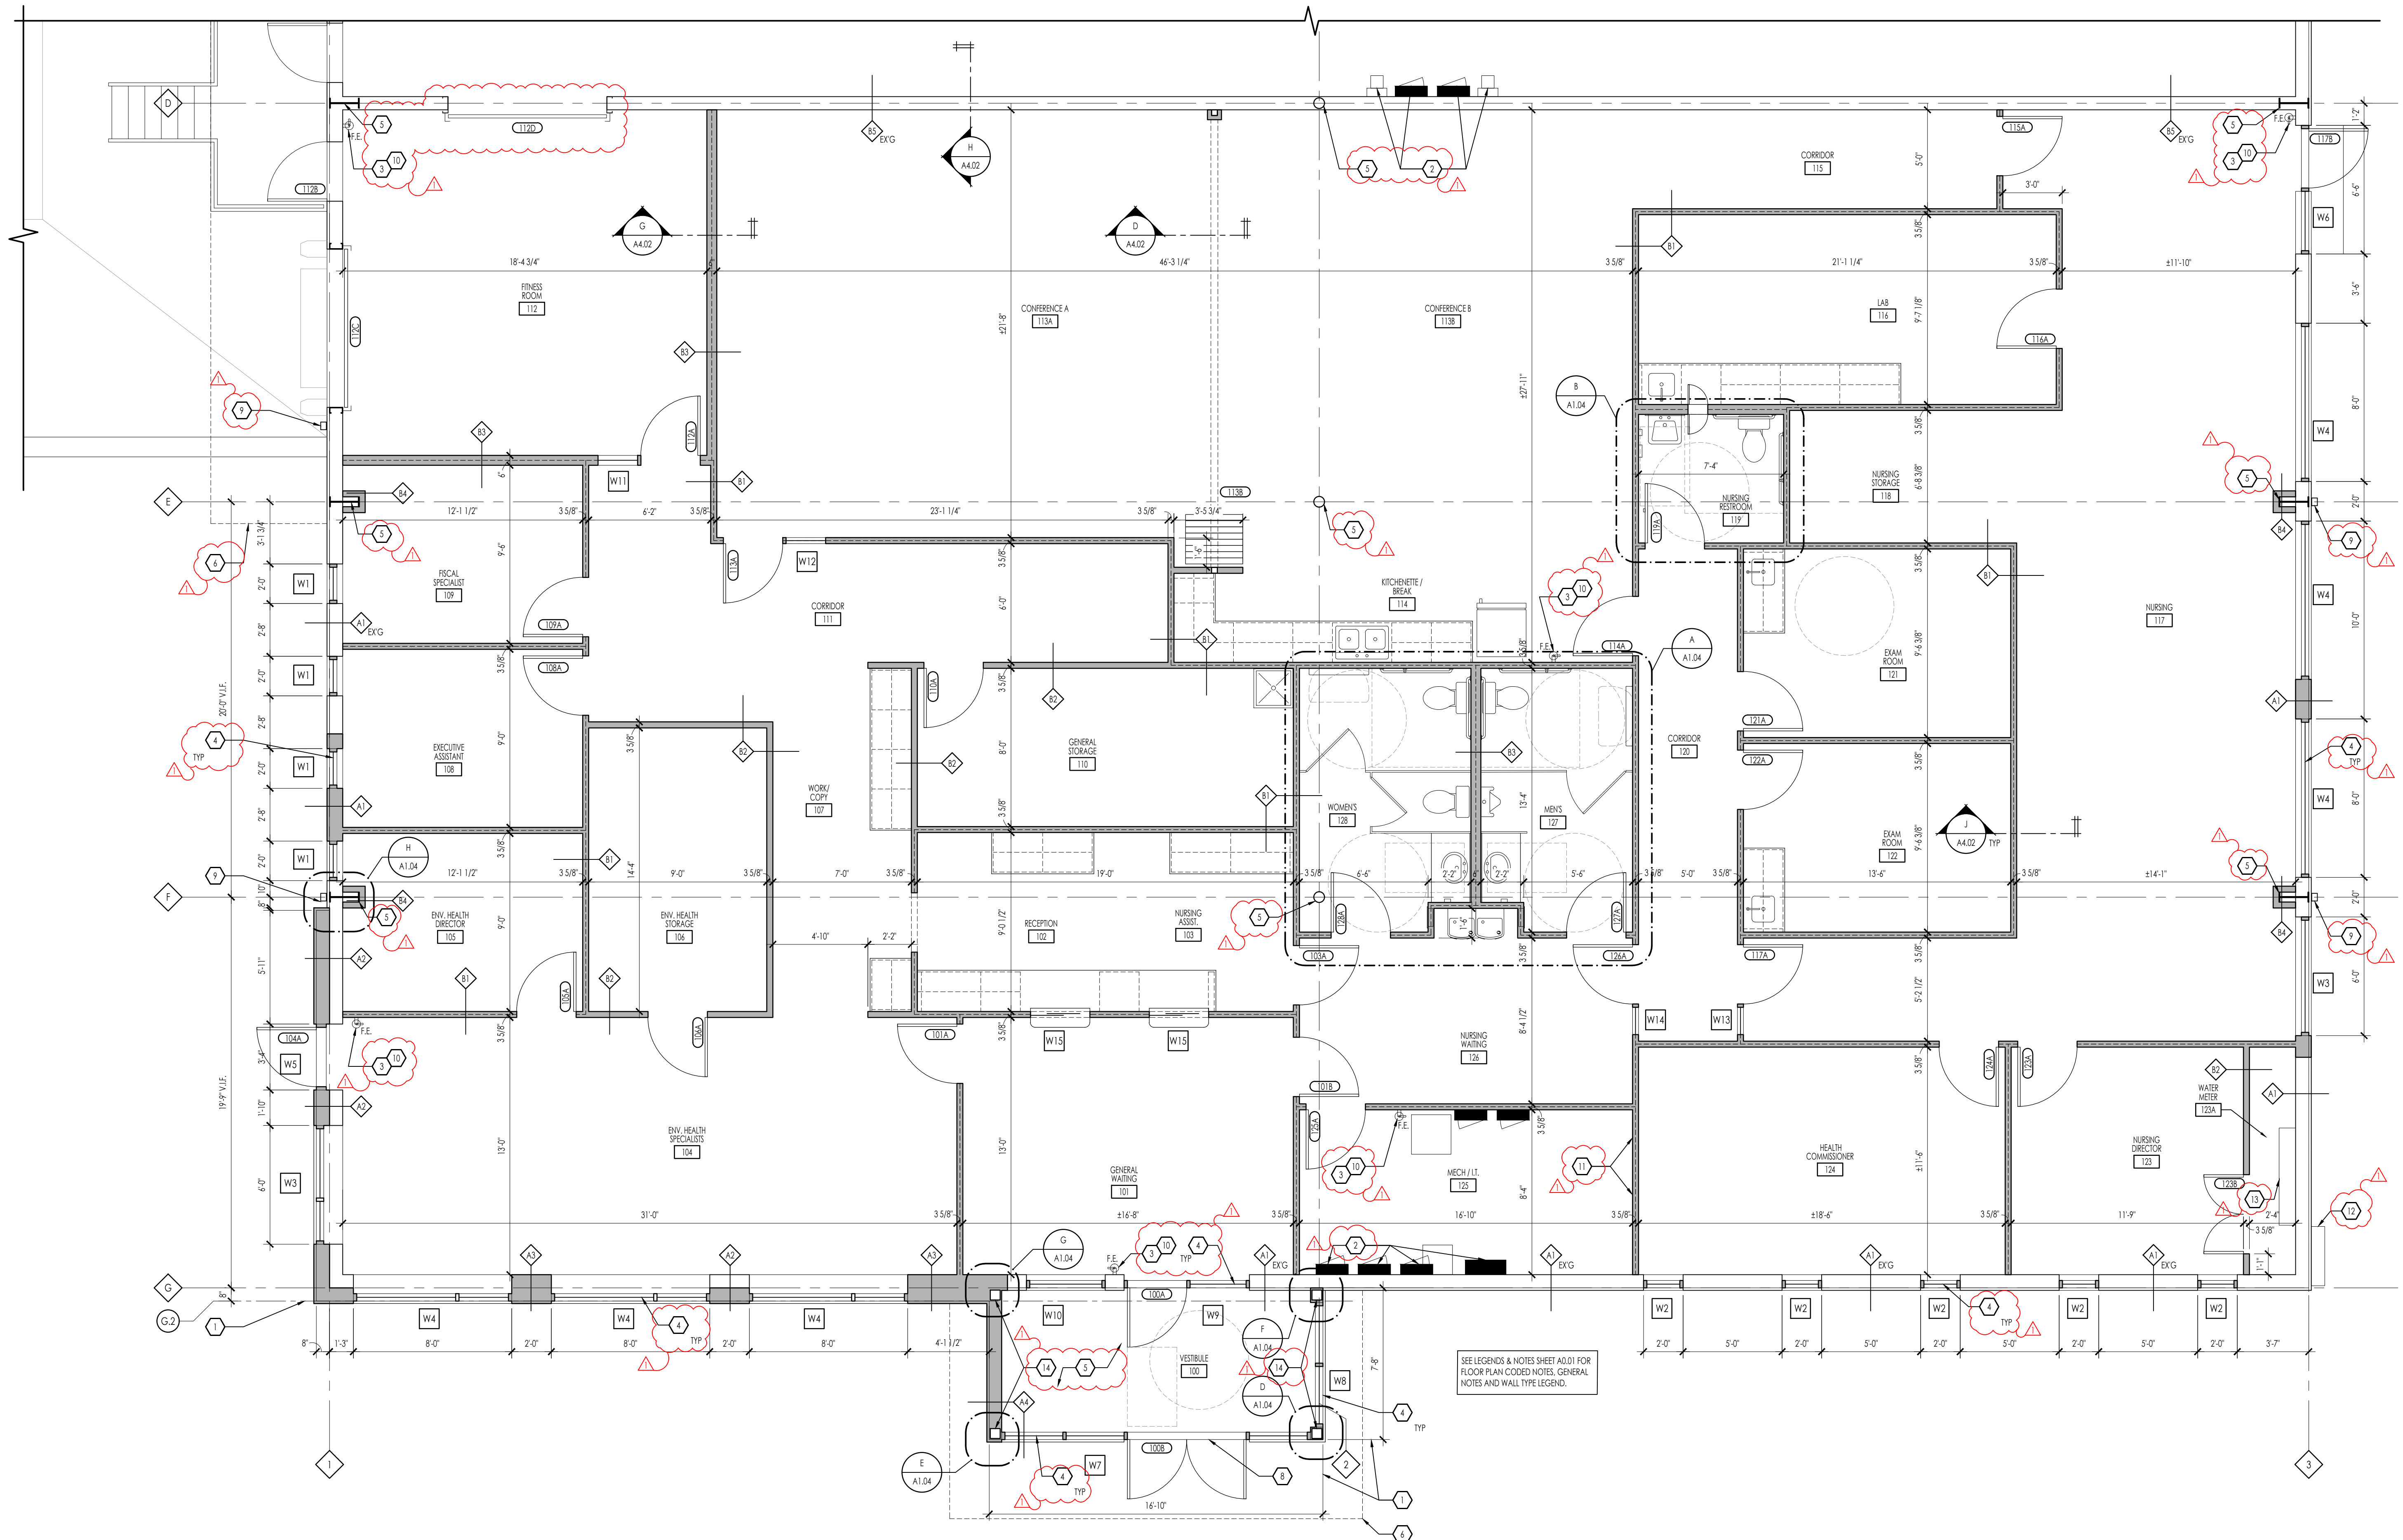

A Proposed Floor Plan
 1/4" = 1'-0"



Client
Morrow County Health District
 480 Douglas St.
 Mt. Gilead, OH 43338

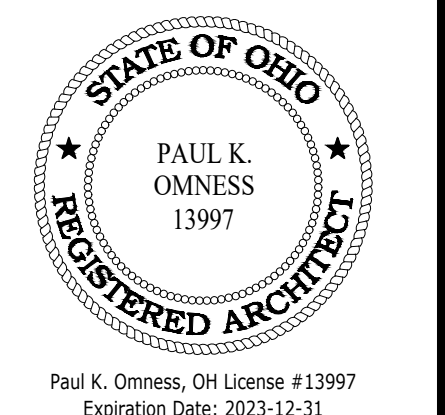


PROJECT
 New Offices for
Morrow County Health District

SHEET INFORMATION


Project #:	2023-029
Issued For:	Permit
Date:	2023-11-06
Revisions:	
	2024-01-31

SHEET TITLE
Proposed Floor Plan


SHEET NUMBER
A1.01

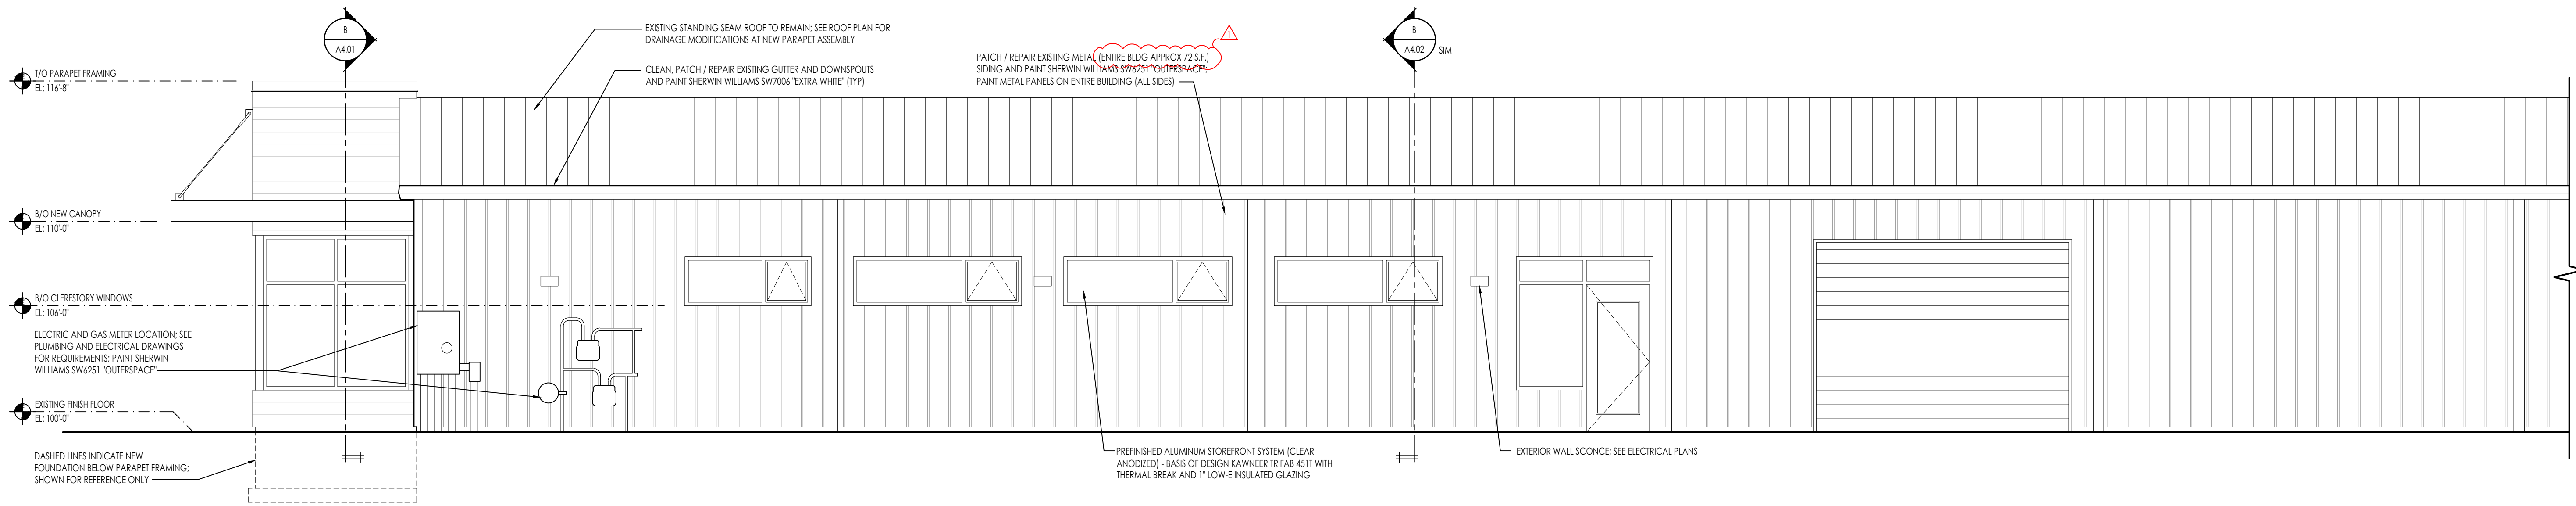

C East Elevation
1/4" = 1'-0"

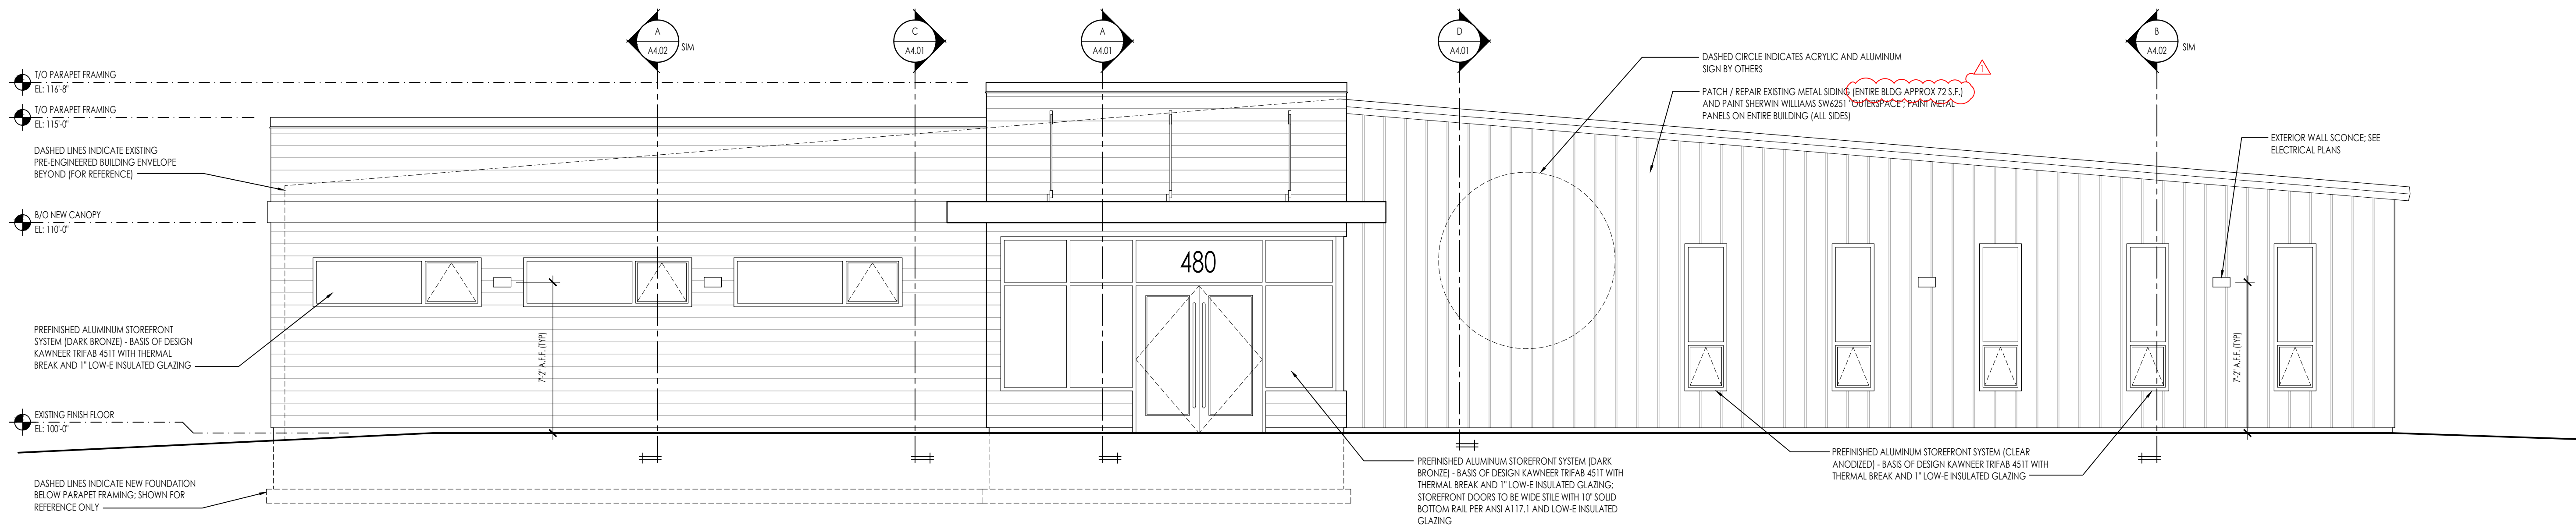

B South Elevation
1/4" = 1'-0"

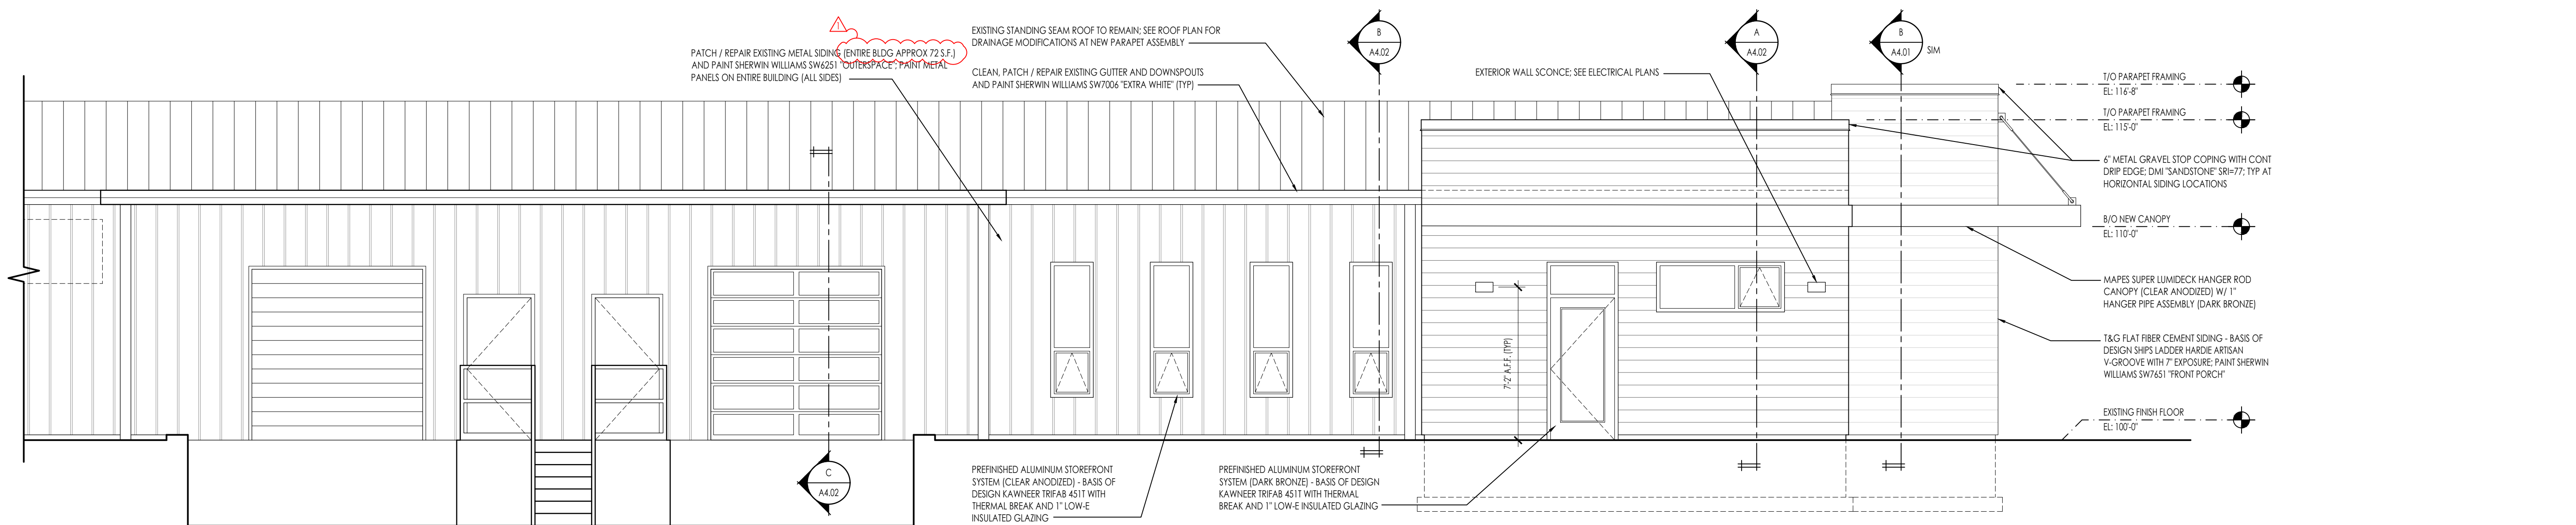

A West Elevation
1/4" = 1'-0"


SHEET INFORMATION

Project #:	2023-029
Issued For:	Permit
Date:	2023-11-06
Revisions:	
	2024-01-31

SHEET TITLE
Exterior Elevations


SHEET NUMBER

A3.01

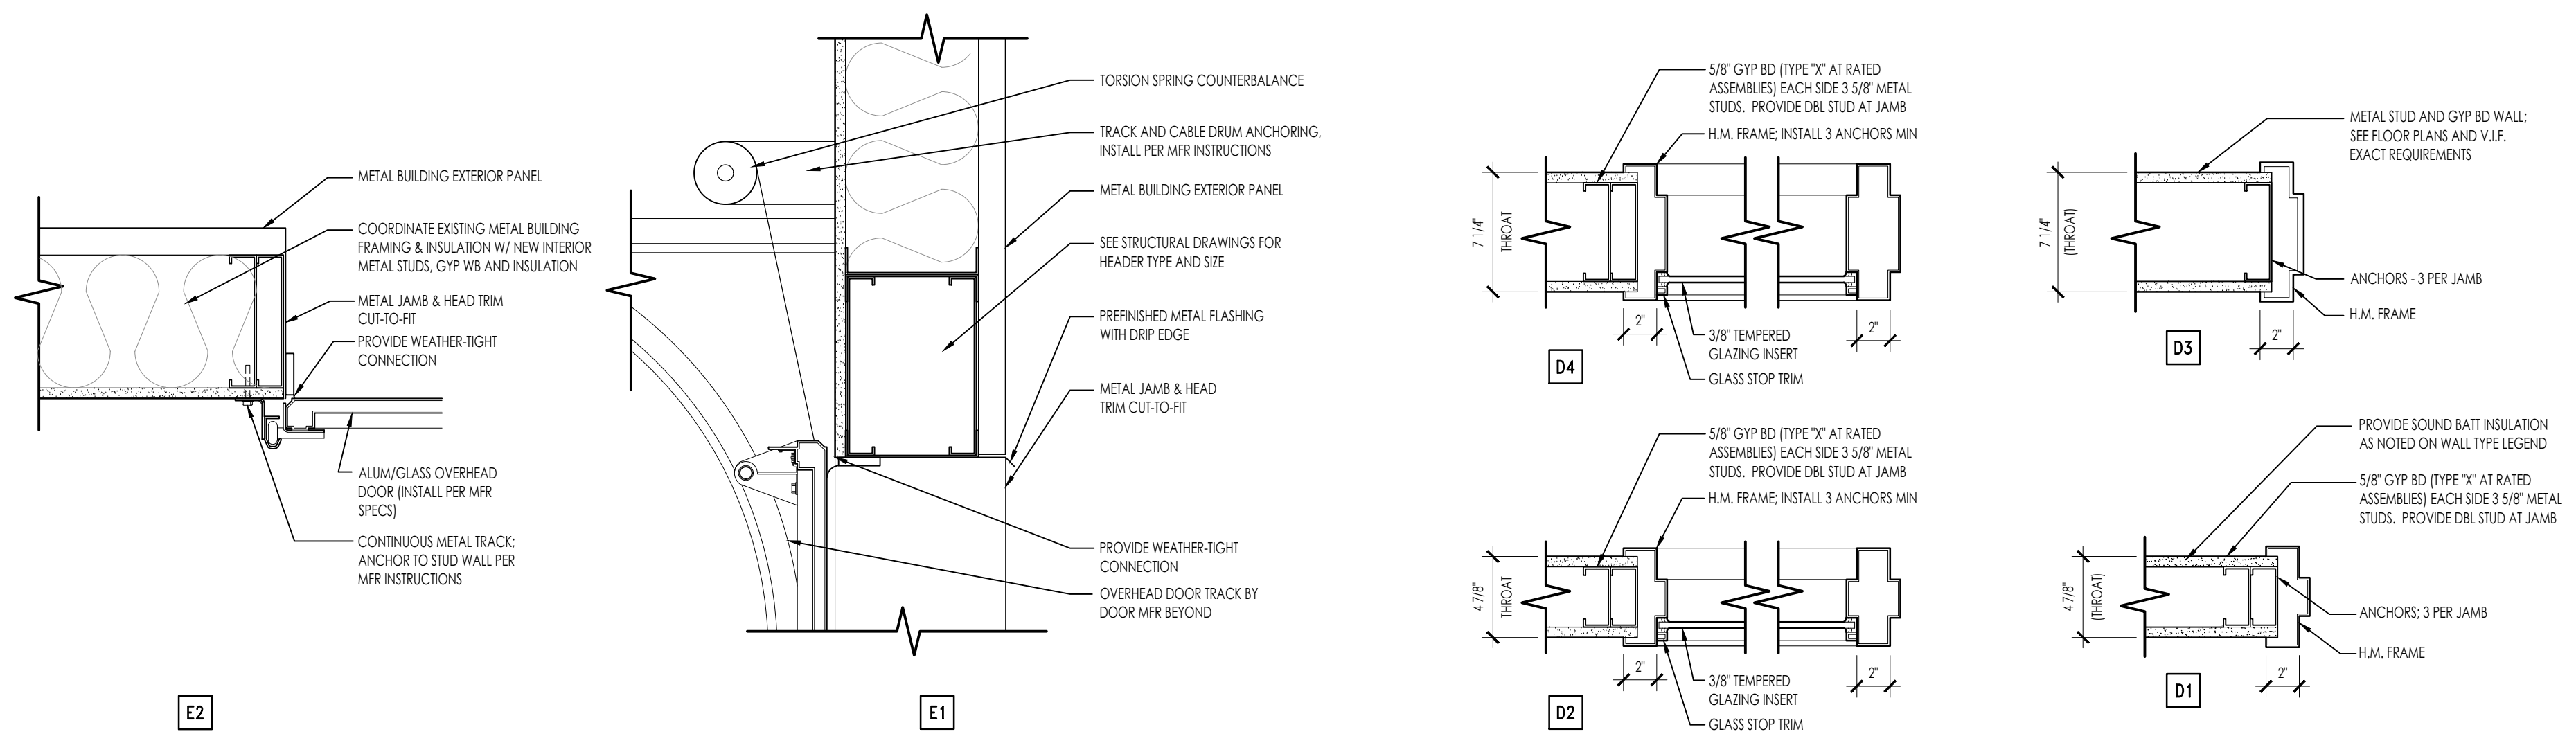


E Overhead Door Frame Details
1 1/2" = 1'-0"


D Hollow Metal Door Frame Details
1 1/2" = 1'-0"

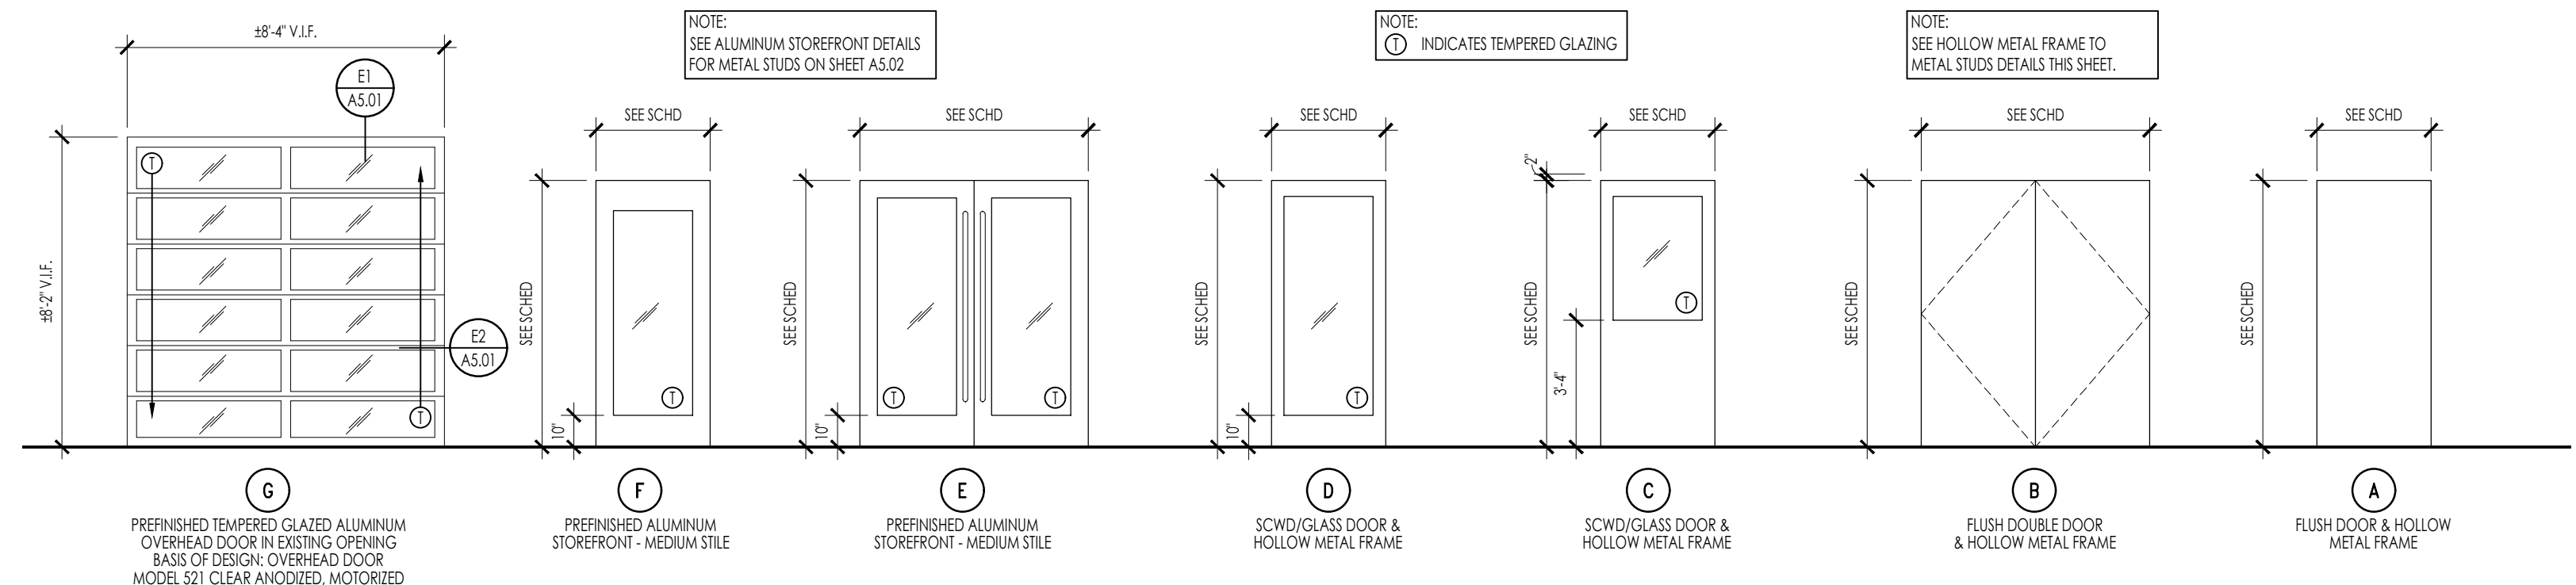

C Door Elevations
1/4" = 1'-0"

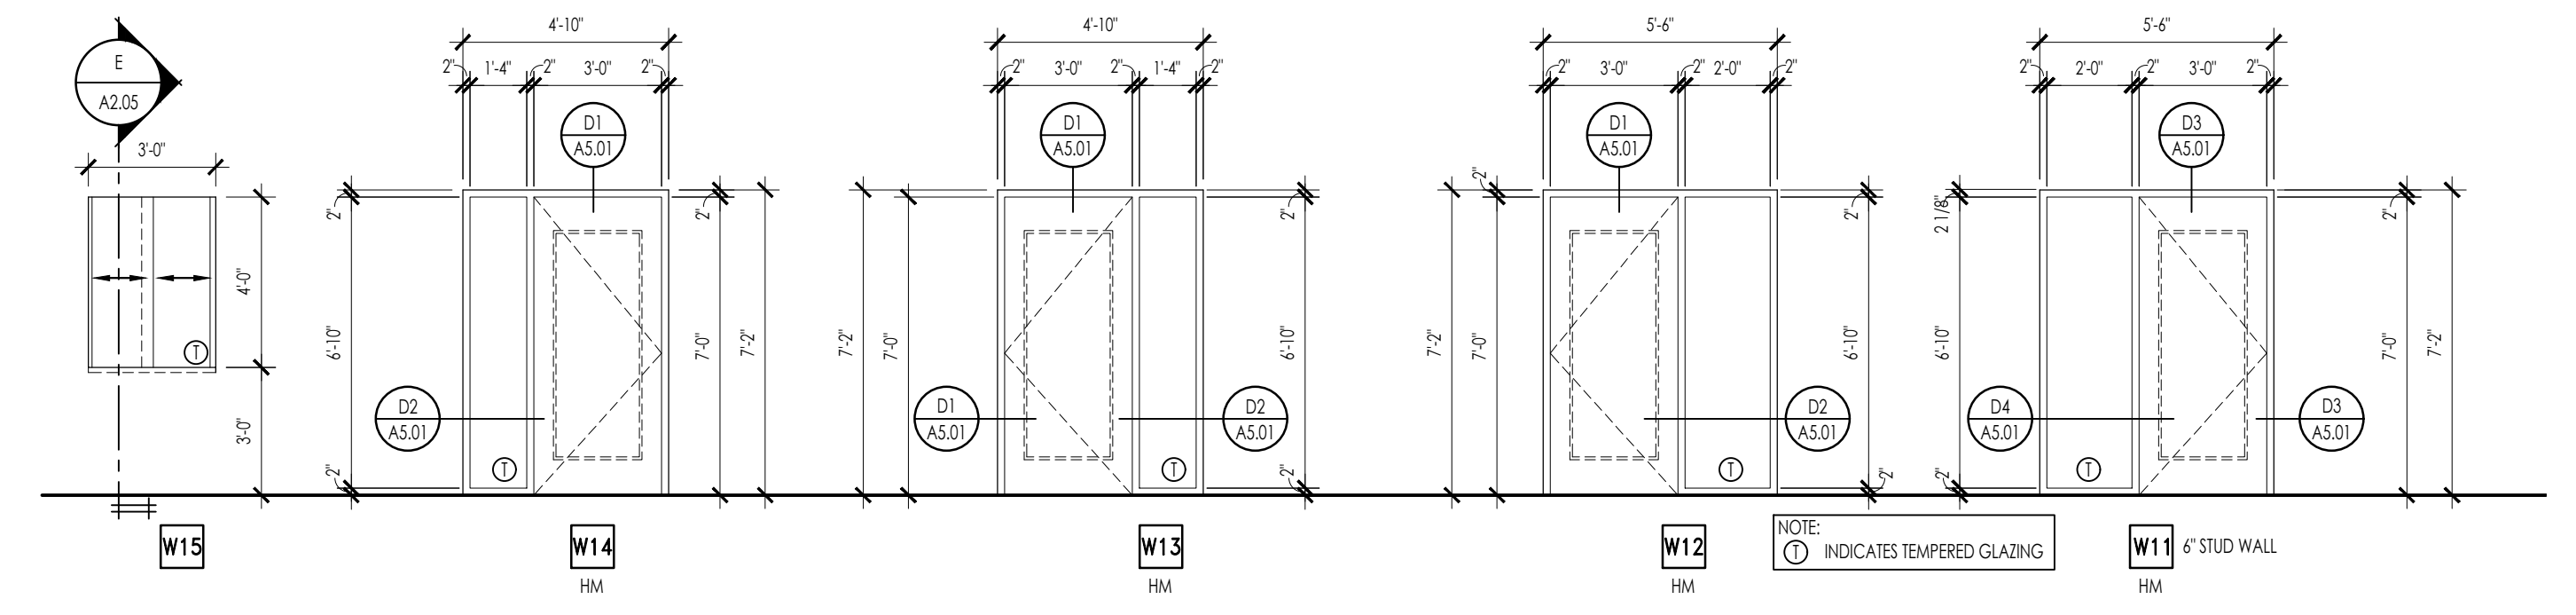

B Hollow Metal Elevations
1/4" = 1'-0"

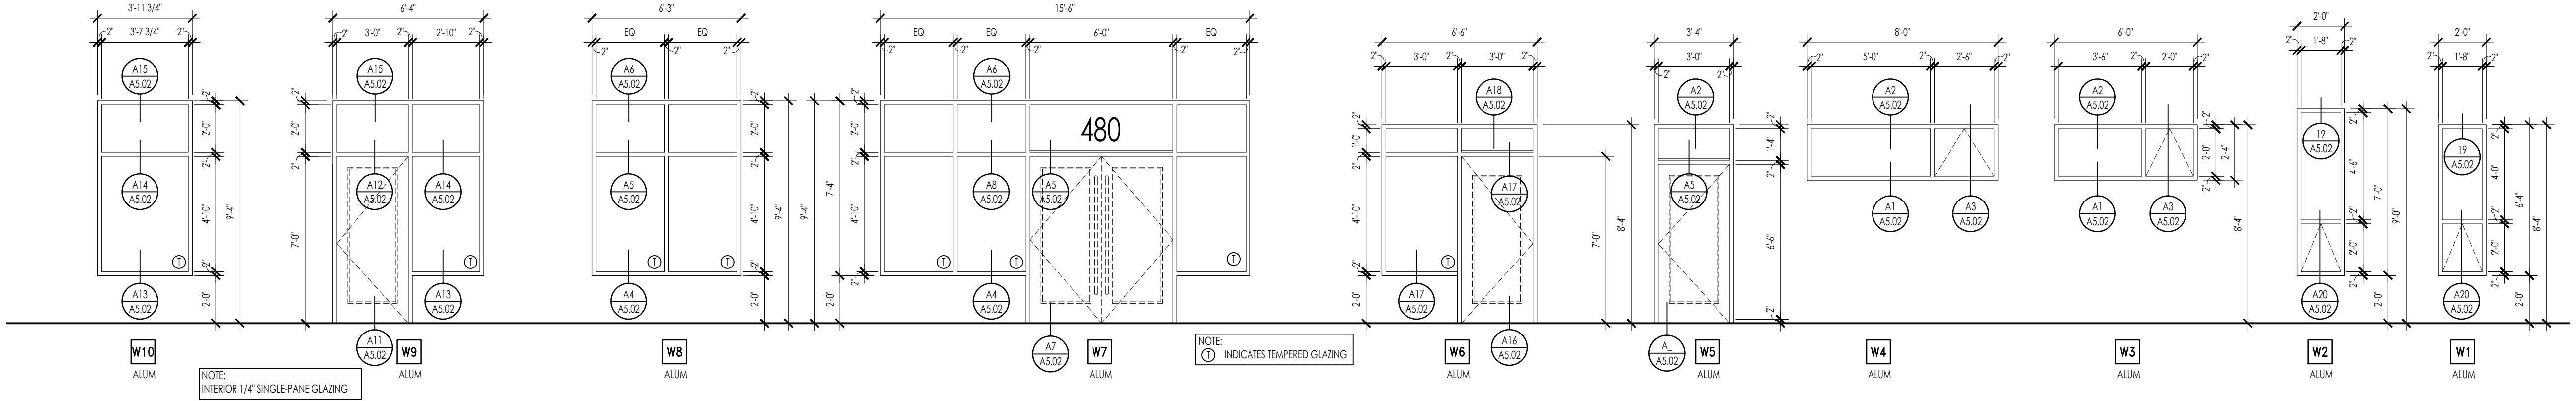

A Aluminum Storefront Elevations
1/4" = 1'-0"

DOOR SCHEDULE								
NO.	TYPE	DOOR DESCRIPTION	FRAME MATERIAL	FRAME FINISH	LEAF MATERIAL	LEAF FINISH	HARDWARE SET	NOTE/REMARKS
100A	F	3'-0" x 7'-0" ENTRY DOOR	ALUM	CLR ANOD	ALUM	CLR ANOD	01	
100B	E	(2) 3'-0" x 7'-0" ENTRY DOOR	ALUM	CLR ANOD	ALUM	CLR ANOD	02	
101A	C	3'-0" x 7'-0" SWING DOOR	HM	PF-1	SCWD/GLASS	ST-1	05	LIMITED ACCESS DOOR W/ ELEC STRIKE
101B	C	3'-0" x 7'-0" SWING DOOR	HM	PF-1	SCWD/GLASS	ST-1	05	LIMITED ACCESS DOOR W/ ELEC STRIKE
103A	C	3'-0" x 7'-0" SWING DOOR	HM	PF-1	SCWD/GLASS	ST-1	03	
104A	E	3'-0" x 7'-0" ENTRY DOOR	ALUM	CLR ANOD	ALUM	CLR ANOD	01	
105A	D	3'-0" x 7'-0" SWING DOOR	HM	PF-1	SCWD/GLASS	ST-1	03	
106A	A	3'-0" x 7'-0" SWING DOOR	HM	PF-1	SCWD	ST-1	04	
108A	D	3'-0" x 7'-0" SWING DOOR	HM	PF-1	SCWD/GLASS	ST-1	03	
109A	A	3'-0" x 7'-0" SWING DOOR	HM	PF-1	SCWD/GLASS	ST-1	03	
110A	A	3'-0" x 7'-0" SWING DOOR	HM	PF-1	SCWD	ST-1	04	
112A	D	3'-0" x 7'-0" SWING DOOR	HM	PF-1	SCWD/GLASS	ST-1	05	
112B	EXISTING	EXISTING DOCK ENTRY DOOR	HM	EXISTING	HM	EXISTING	---	4 (NEEDS LOCKSET REPLACED W/ LEVER HANDLE)
112C	G	48'-4" x 8'-2" OVERHEAD PANEL DOOR	ALUM	CLR ANOD	ALUM/GLASS	CLR ANOD	---	NEW O.H. DOOR IN EXISTING OPENING - V.I.F.
112D	EXISTING	EXISTING OVERHEAD DOOR	HM	EXISTING	HM	EXISTING	---	EXISTING HARDWARE TO REMAIN
113A	D	3'-0" x 7'-0" SWING DOOR	HM	PF-1	SCWD/GLASS	ST-1	06	
113B	-	23'-2" x 10'-0" ROOM DIVIDER PANEL DOOR	-	-	-	-	-	MODERNFOLD ACOUSTICAL LEGACY (STC 50)
114A	C	3'-0" x 7'-0" SWING DOOR	HM	PF-1	SCWD/GLASS	ST-1	05	LIMITED ACCESS DOOR W/ ELEC STRIKE
115A	A	3'-0" x 7'-0" SWING DOOR	HM	PF-1	SCWD	ST-1	06	
116A	C	3'-0" x 7'-0" SWING DOOR	HM	PF-1	SCWD/GLASS	ST-1	03	
117A	C	3'-0" x 7'-0" SWING DOOR	HM	PF-1	SCWD/GLASS	ST-1	05	LIMITED ACCESS DOOR W/ ELEC STRIKE
117B	F	3'-0" x 7'-0" ENTRY DOOR	ALUM	CLR ANOD	ALUM	CLR ANOD	01	
119A	A	3'-0" x 7'-0" SWING DOOR	HM	PF-1	SCWD	ST-1	07	
121A	A	3'-0" x 7'-0" SWING DOOR	HM	PF-1	SCWD	ST-1	06	
122A	A	3'-0" x 7'-0" SWING DOOR	HM	PF-1	SCWD	ST-1	06	
123A	D	3'-0" x 7'-0" SWING DOOR	HM	PF-1	SCWD/GLASS	ST-1	03	
123B	A	(2) 3'-0" x 7'-0" SWING DOOR	HM	PF-1	SCWD	ST-1	04	
124A	D	3'-0" x 7'-0" SWING DOOR	HM	PF-1	SCWD/GLASS	ST-1	03	
125A	A	3'-0" x 7'-0" SWING DOOR	HM	PF-1	SCWD	ST-1	05	LIMITED ACCESS DOOR W/ ELEC STRIKE
126A	C	3'-0" x 7'-0" SWING DOOR	HM	PF-1	SCWD/GLASS	ST-1	05	LIMITED ACCESS DOOR W/ ELEC STRIKE
127A	A	3'-0" x 7'-0" SWING DOOR	HM	PF-1	SCWD	ST-1	08	
128A	A	3'-0" x 7'-0" SWING DOOR	HM	PF-1	SCWD	ST-1	08	

NOTES/REMARKS
 1. REFER TO FINISH PLAN FOR FINISH REQUIREMENTS.
 2. INSTALL HARDWARE PER MANUFACTURER'S INSTRUCTIONS.
 3. H.M. DOOR FRAME TO BE KNOCK-DOWN TYPE. SEE DETAILS FOR ADDITIONAL WELDED / KNOCK-DOWN FRAME REQUIREMENTS.
 4. EXISTING DOOR TO REMAIN; COORDINATE EXISTING LEAF FINISH WITH TENANT AND ARCHITECT.

HARDWARE SET 01 (SINGLE ENTRY)	HARDWARE SET 05
3 HINGE: 881 4.5 X 4.5 - 652 (HAG)	3 HINGE: 881 4.5 X 4.5 - 652 (IVE)
1 EXIT DEVICE: 554L E.O. - 626 (VON)	1 PASSAGE SET: 1101 DAM - 626 (FAL)
1 CYLINDER: 20-022 - 626 (SCH)	1 SFC CORE: C607 - 626 (FAL)
1 PULL: 8103-2 - 630 (IVE)	1 SURFACE CLOSER: 4111 - 689 (LCN)
1 CLOSER: 4111 X.D.P. X.61 - 689 (LCN)	1 SILENCER: 3864 - GRV (IVE)
1 O.V.H.D. STOP: 1005 - 630 (GLY)	1 WALL STOP: W546/407CCV - 630 (IVE)
1 THRESHOLD: 896-5 - 626 (NGP)	or (1) OVERHEAD STOP: SC60A-3077DS - 689 (FAL)
HARDWARE SET 02 (DOUBLE ENTRY)	HARDWARE SET 06
6 HINGE: 881 4.5 X 4.5 - 652 (HAG)	3 HINGE: 881 4.5 X 4.5 - 652 (IVE)
1 EXIT DEVICE: 554L E.O. - 626 (VON)	1 CLASSROOM LOCK: 1561BDC QUA - 626 (FAL)
1 CYLINDER: 20-022 - 626 (SCH)	1 SFC CORE: C607 - 626 (FAL)
1 PULL: 8103-2 - 630 (IVE)	1 SURFACE CLOSER: SC71 REG OR PA AS REQ'D - 689 (FAL)
2 CLOSER: 4111 X.D.P. X.61 - 689 (LCN)	1 SILENCER: 3864 - GRV (IVE)
2 O.V.H.D. STOP: 1005 - 630 (GLY)	1 WALL STOP: W546/407CCV - 630 (IVE)
1 THRESHOLD: 896-5 - 626 (NGP)	or (1) OVERHEAD STOP: SC60A-3077DS - 689 (FAL)
HARDWARE SET 03 (OFFICE)	HARDWARE SET 07 (UNISEX RESTROOM)
3 HINGE: 881 4.5 X 4.5 - 652 (IVE)	3 HINGE: 881 4.5 X 4.5 - 652 (IVE)
1 OFFICE LOCK: 1511BDC QUA - 626 (FAL)	1 PRIVACY LOCK: MA30 OCCUPIED/VACANT QGM - 626 (FAL)
1 SFC CORE: C607 - 626 (FAL)	1 KICKPLATE: 8400 8' X 1 1/2" LDW 8-CS - 630 (IVE)
1 SILENCER: 3864 - GRV (IVE)	1 WALL STOP: W546/407CCV - 630 (IVE)
1 WALL STOP: W546/407CCV - 630 (IVE)	1 SILENCER: 3864 - GRV (IVE)
or (1) OVERHEAD STOP: SC60A-3077DS - 689 (FAL)	
HARDWARE SET 04	HARDWARE SET 08 (MULTI-USE RESTROOM)
3 HINGE: 881 4.5 X 4.5 - 652 (IVE)	3 HINGE: 881 4.5 X 4.5 - 652 (HAG)
1 STOREROOM LOCK: 1581BDC QUA - 626 (FAL)	1 PUSH PLATE: 6200 4' X 16" - 626 (IVE)
1 SFC CORE: C607 - 626 (FAL)	1 PULL PLATE: 83020 4' X 16" - 626 (IVE)
1 SILENCER: 3864 - GRV (IVE)	1 SURFACE CLOSER: 4111 - 689 (LCN)
1 WALL STOP: W546/407CCV - 630 (IVE)	1 KICK PLATE: 8400 8' X 34" - 630 (IVE)
or (1) OVERHEAD STOP: SC60A-3077DS - 689 (FAL)	1 WALL STOP: W546/407CCV - 630 (IVE)
	or (1) OVERHEAD STOP: SC60A-3077DS - 689 (FAL)

SHEET INFORMATION

Project #:	2023-029
Issued For:	Permit
Date:	2023-11-06
Revisions:	2024-01-31

SHEET TITLE
Door & Window Schedules & Details
 SHEET NUMBER

A5.01